
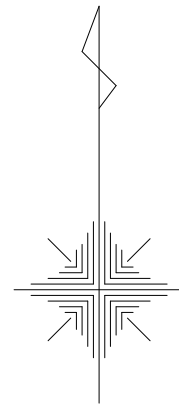
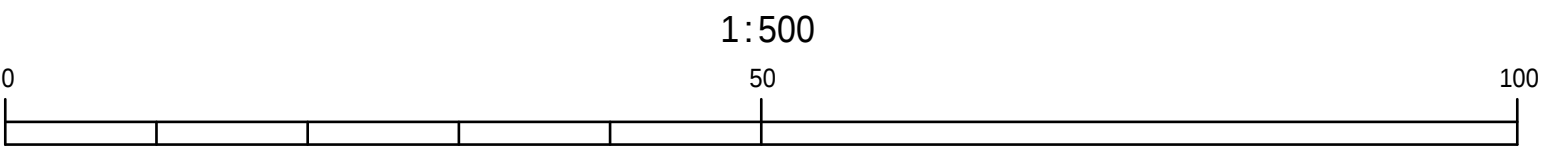
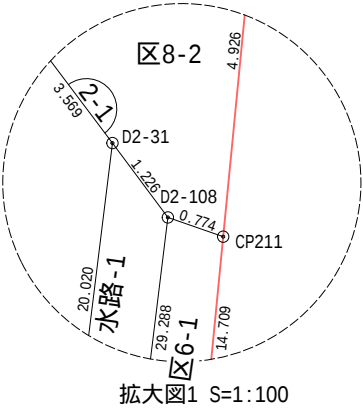
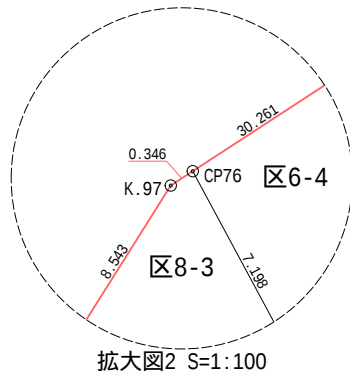


画地出来形確認測量図1

縮尺1:500

平成三十年二月


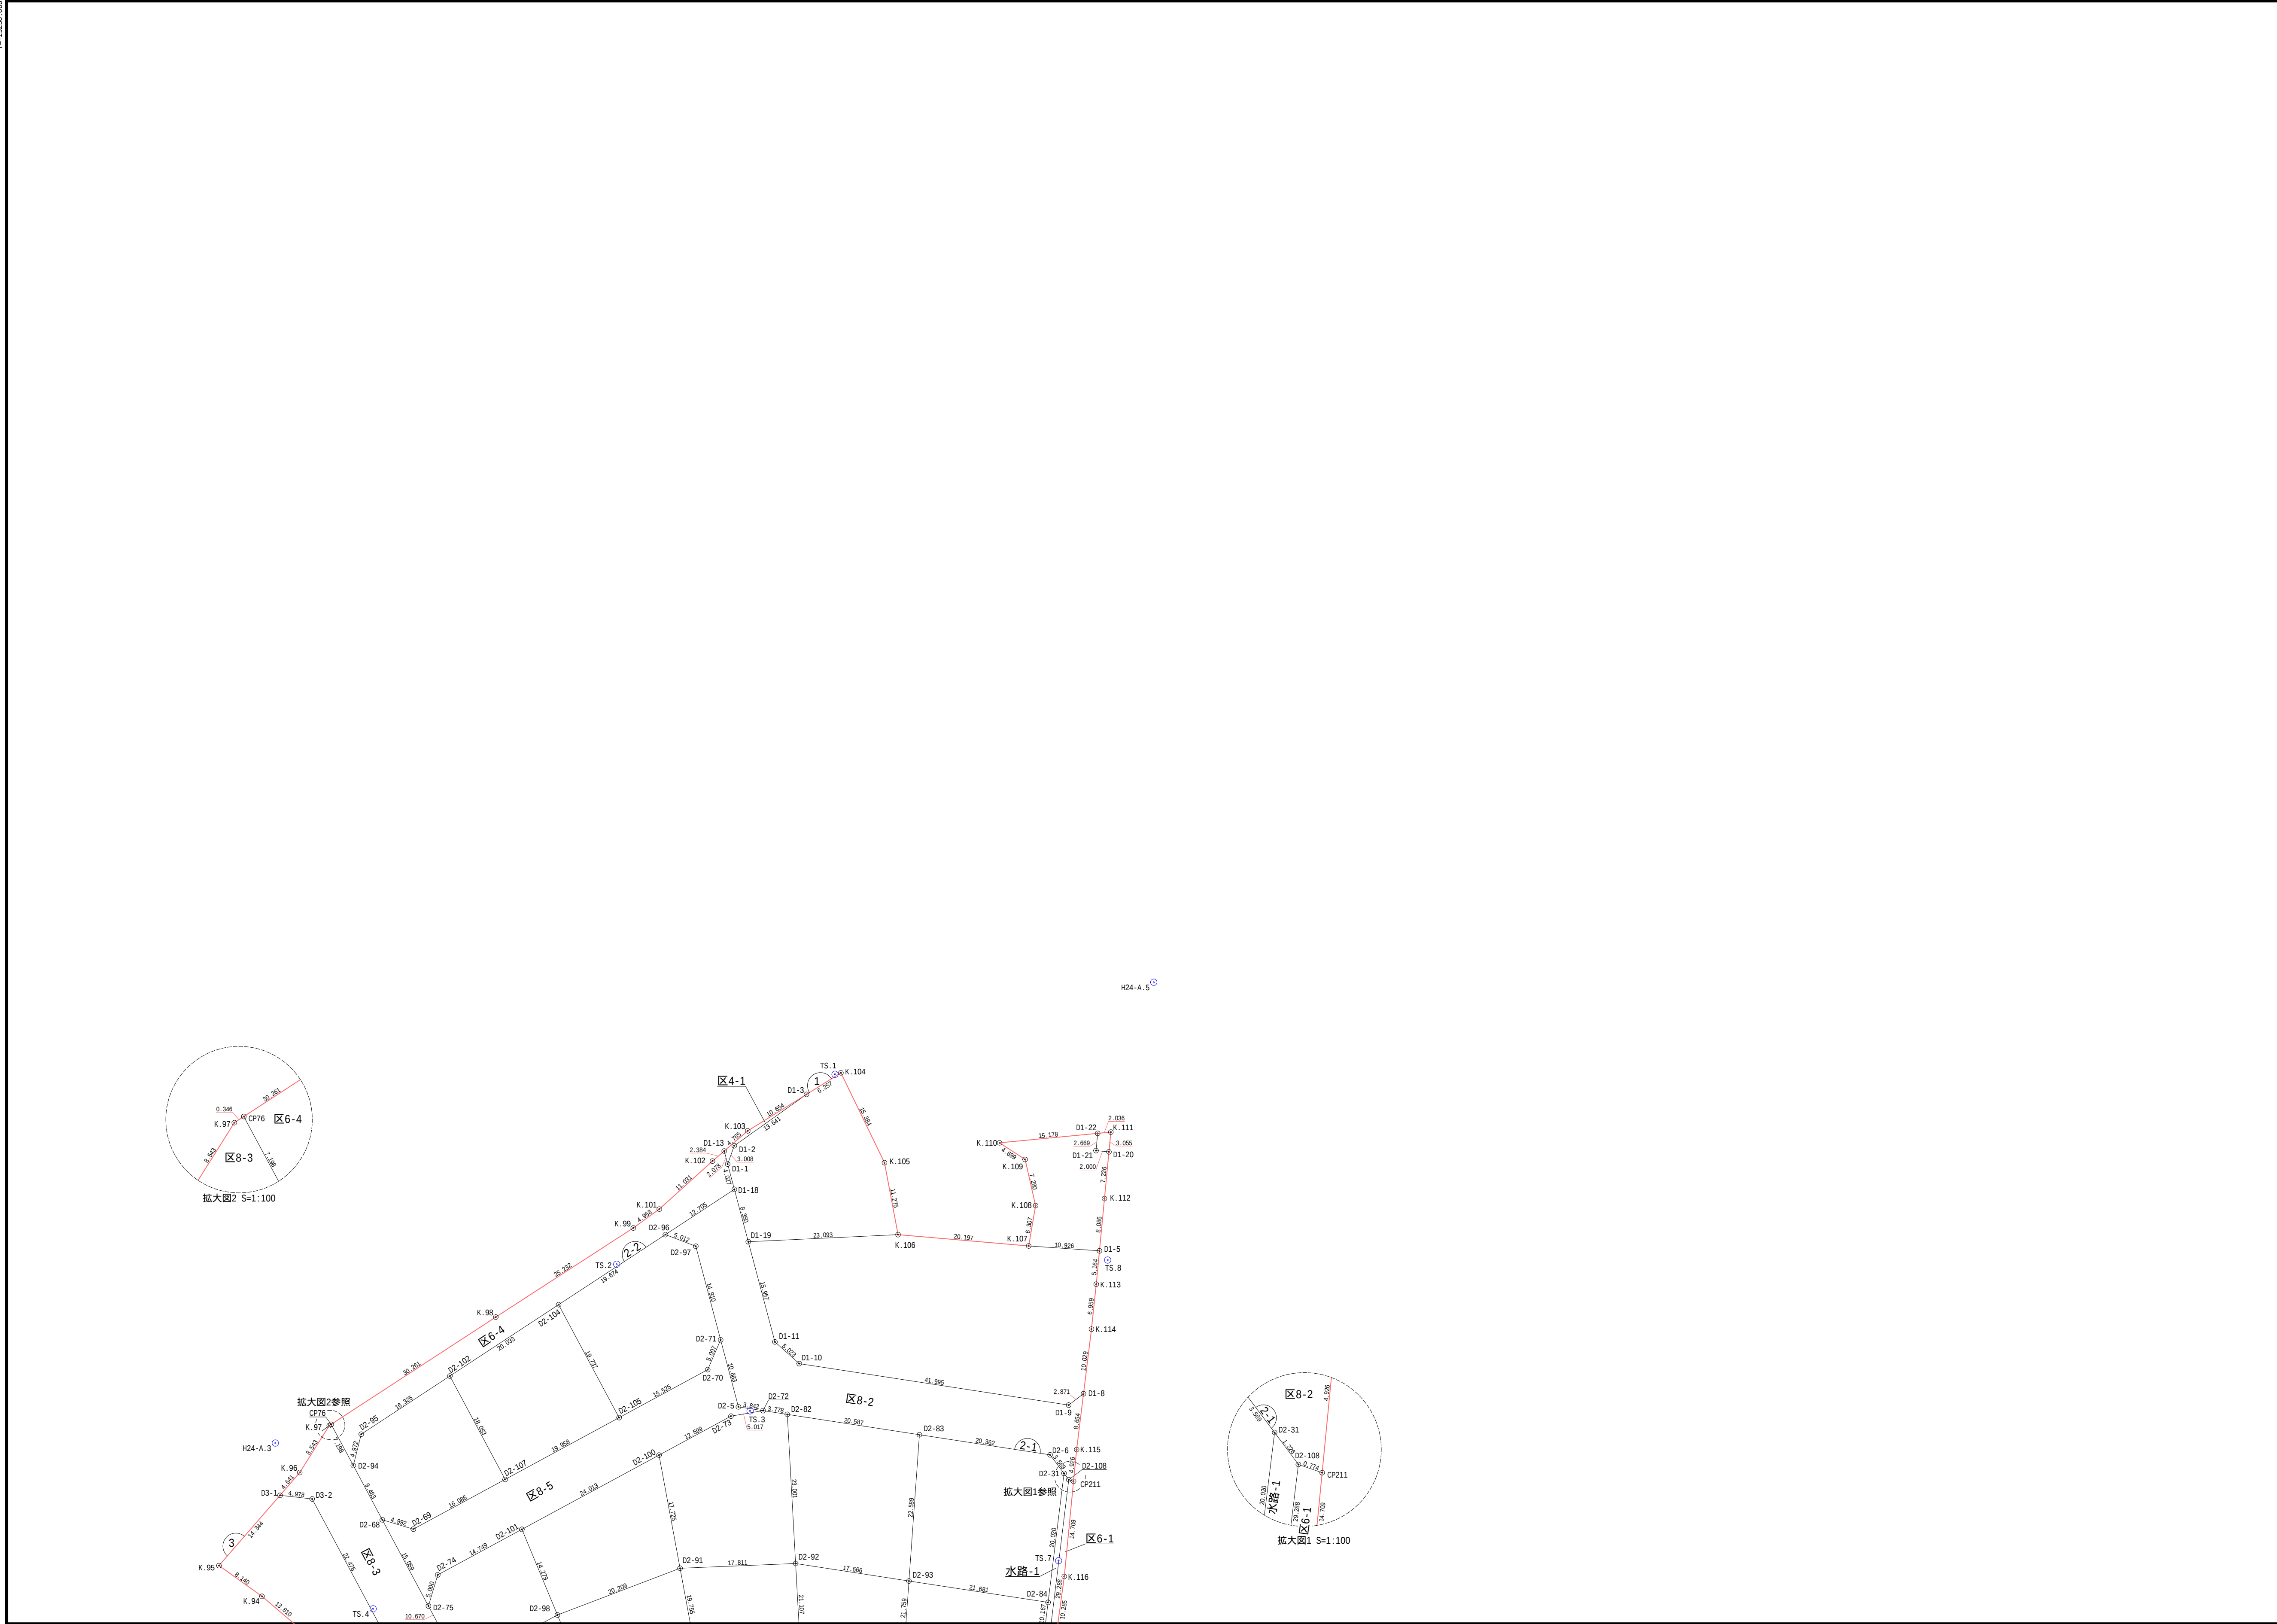


	1	
2	3	

図面番号 KE64-20-11

佐野市

三立調査設計株式会社

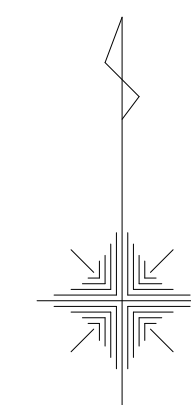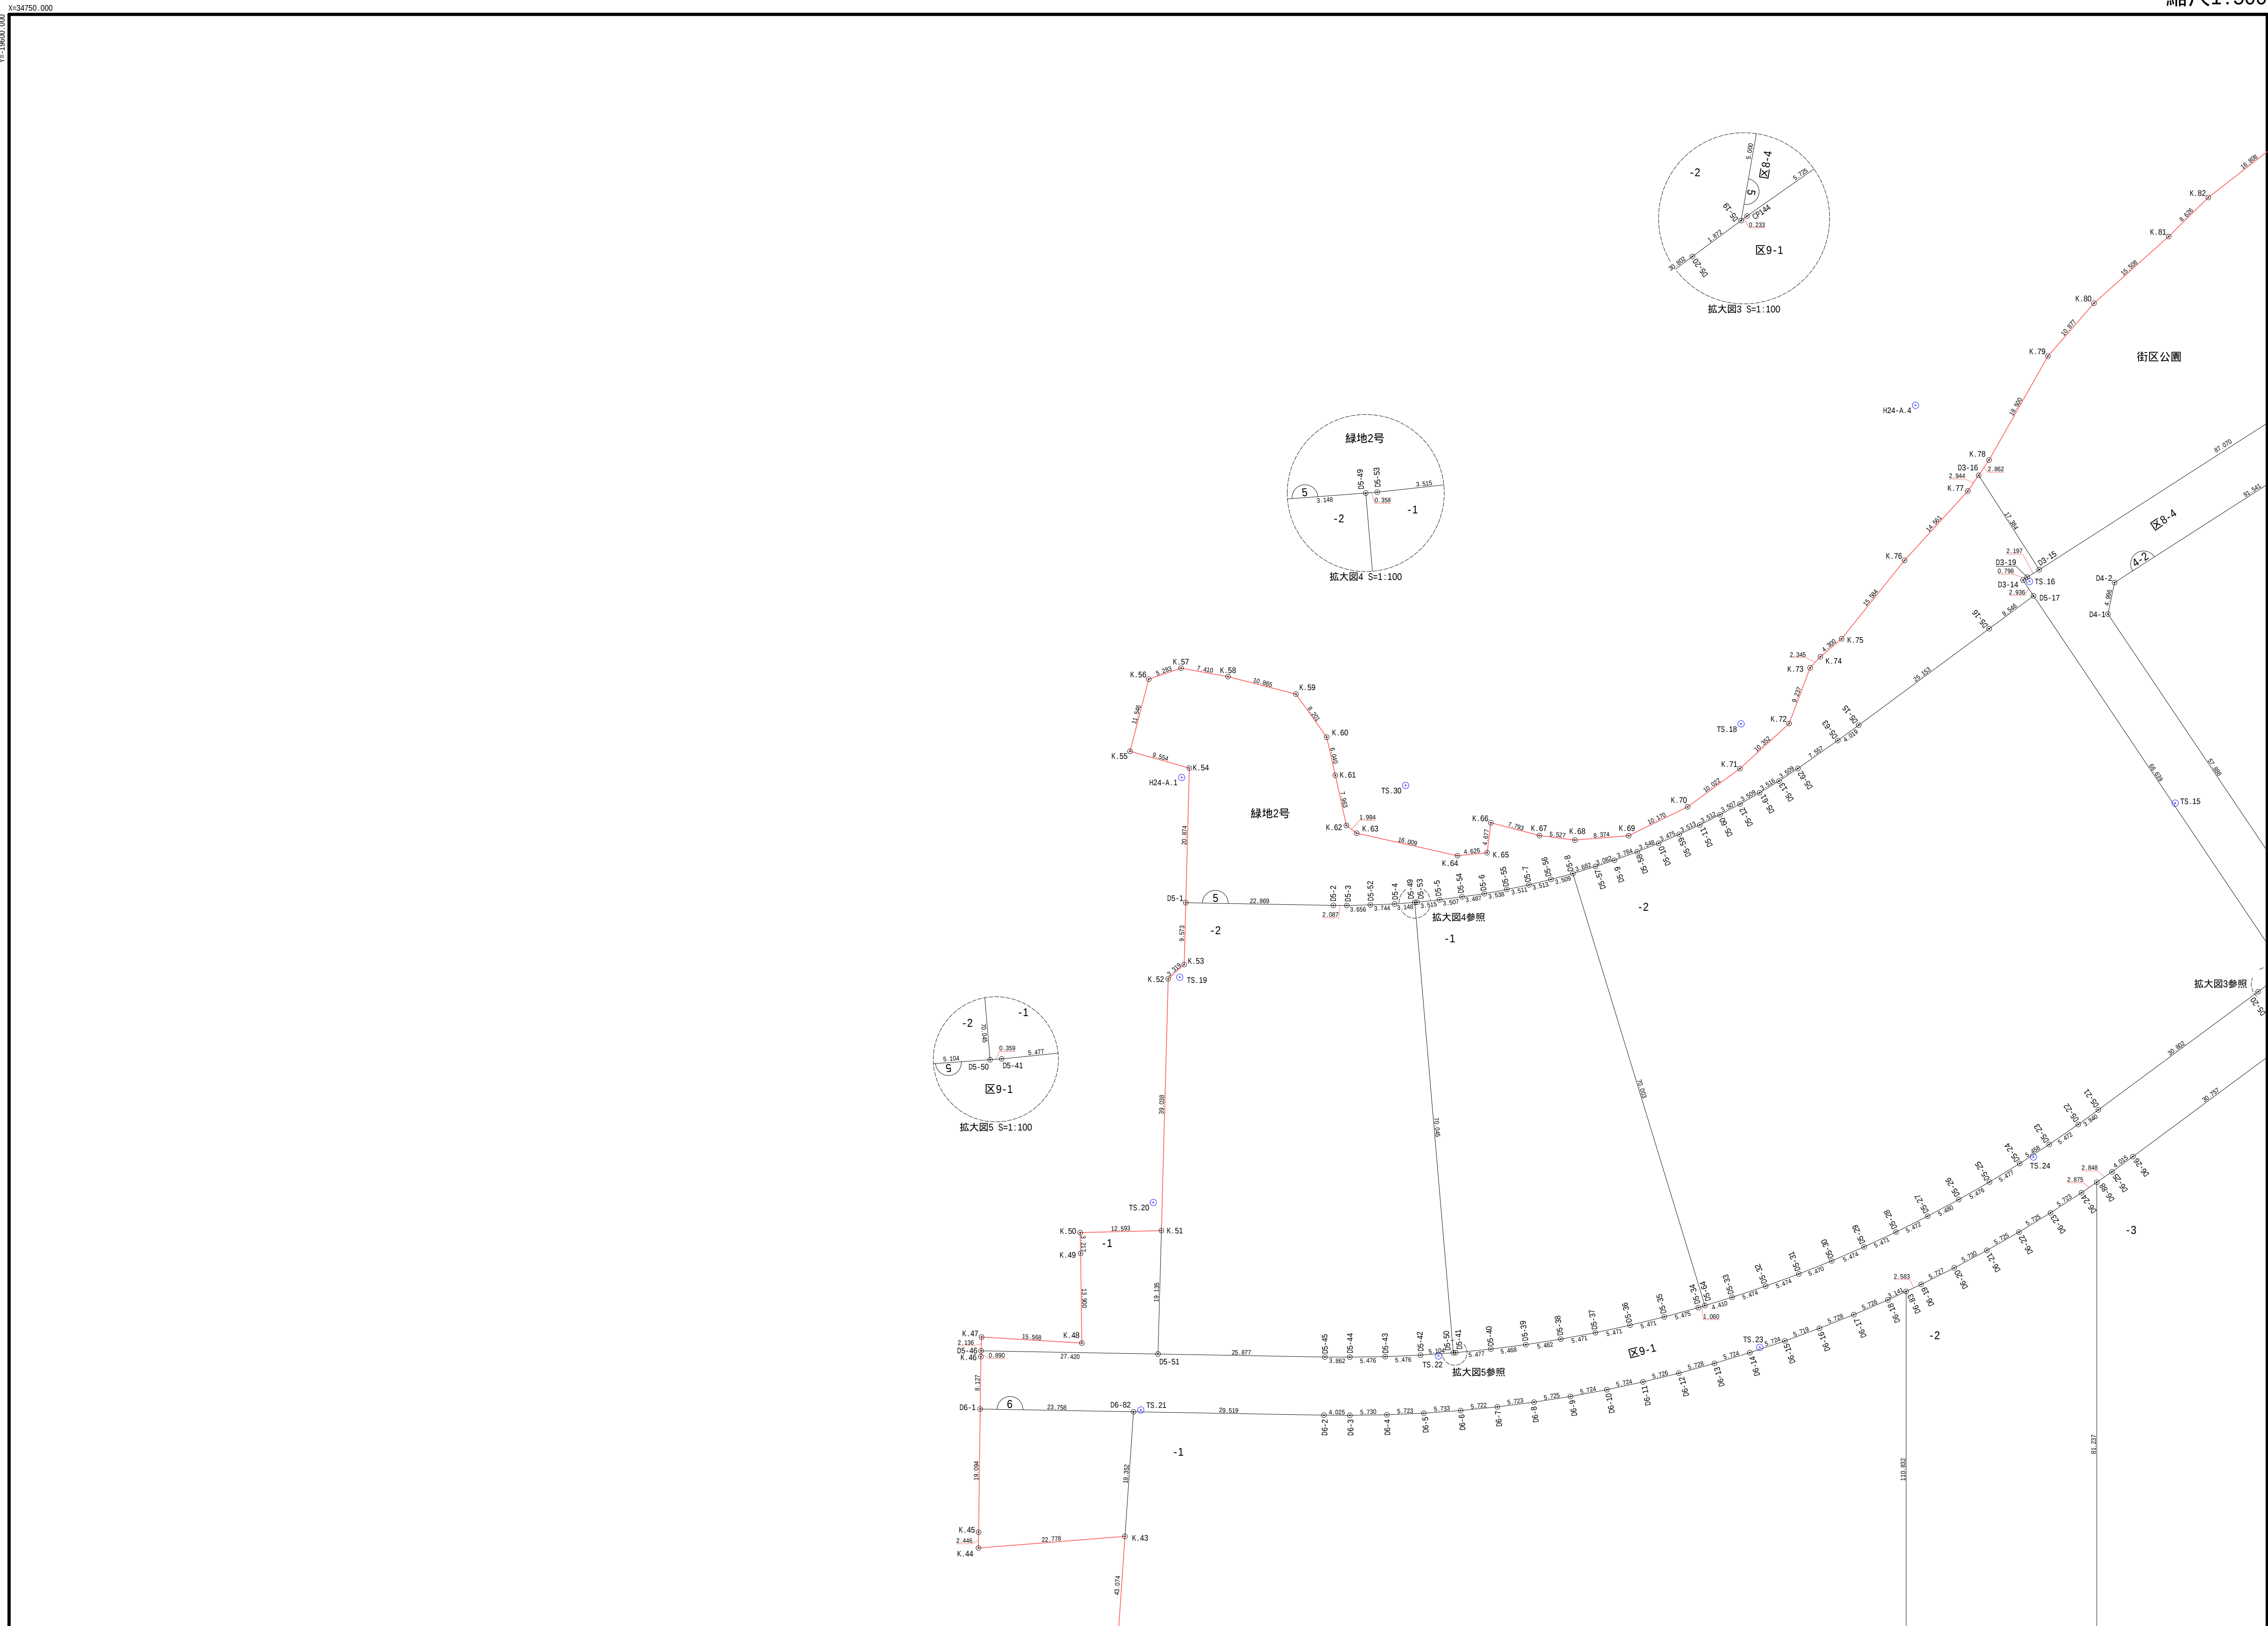

		1
	2	3
	4	5



図面番号 KE64-10-25

佐野市

画地出来形確認測量図3

縮尺1:500

平成三十年二月

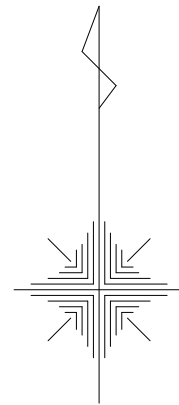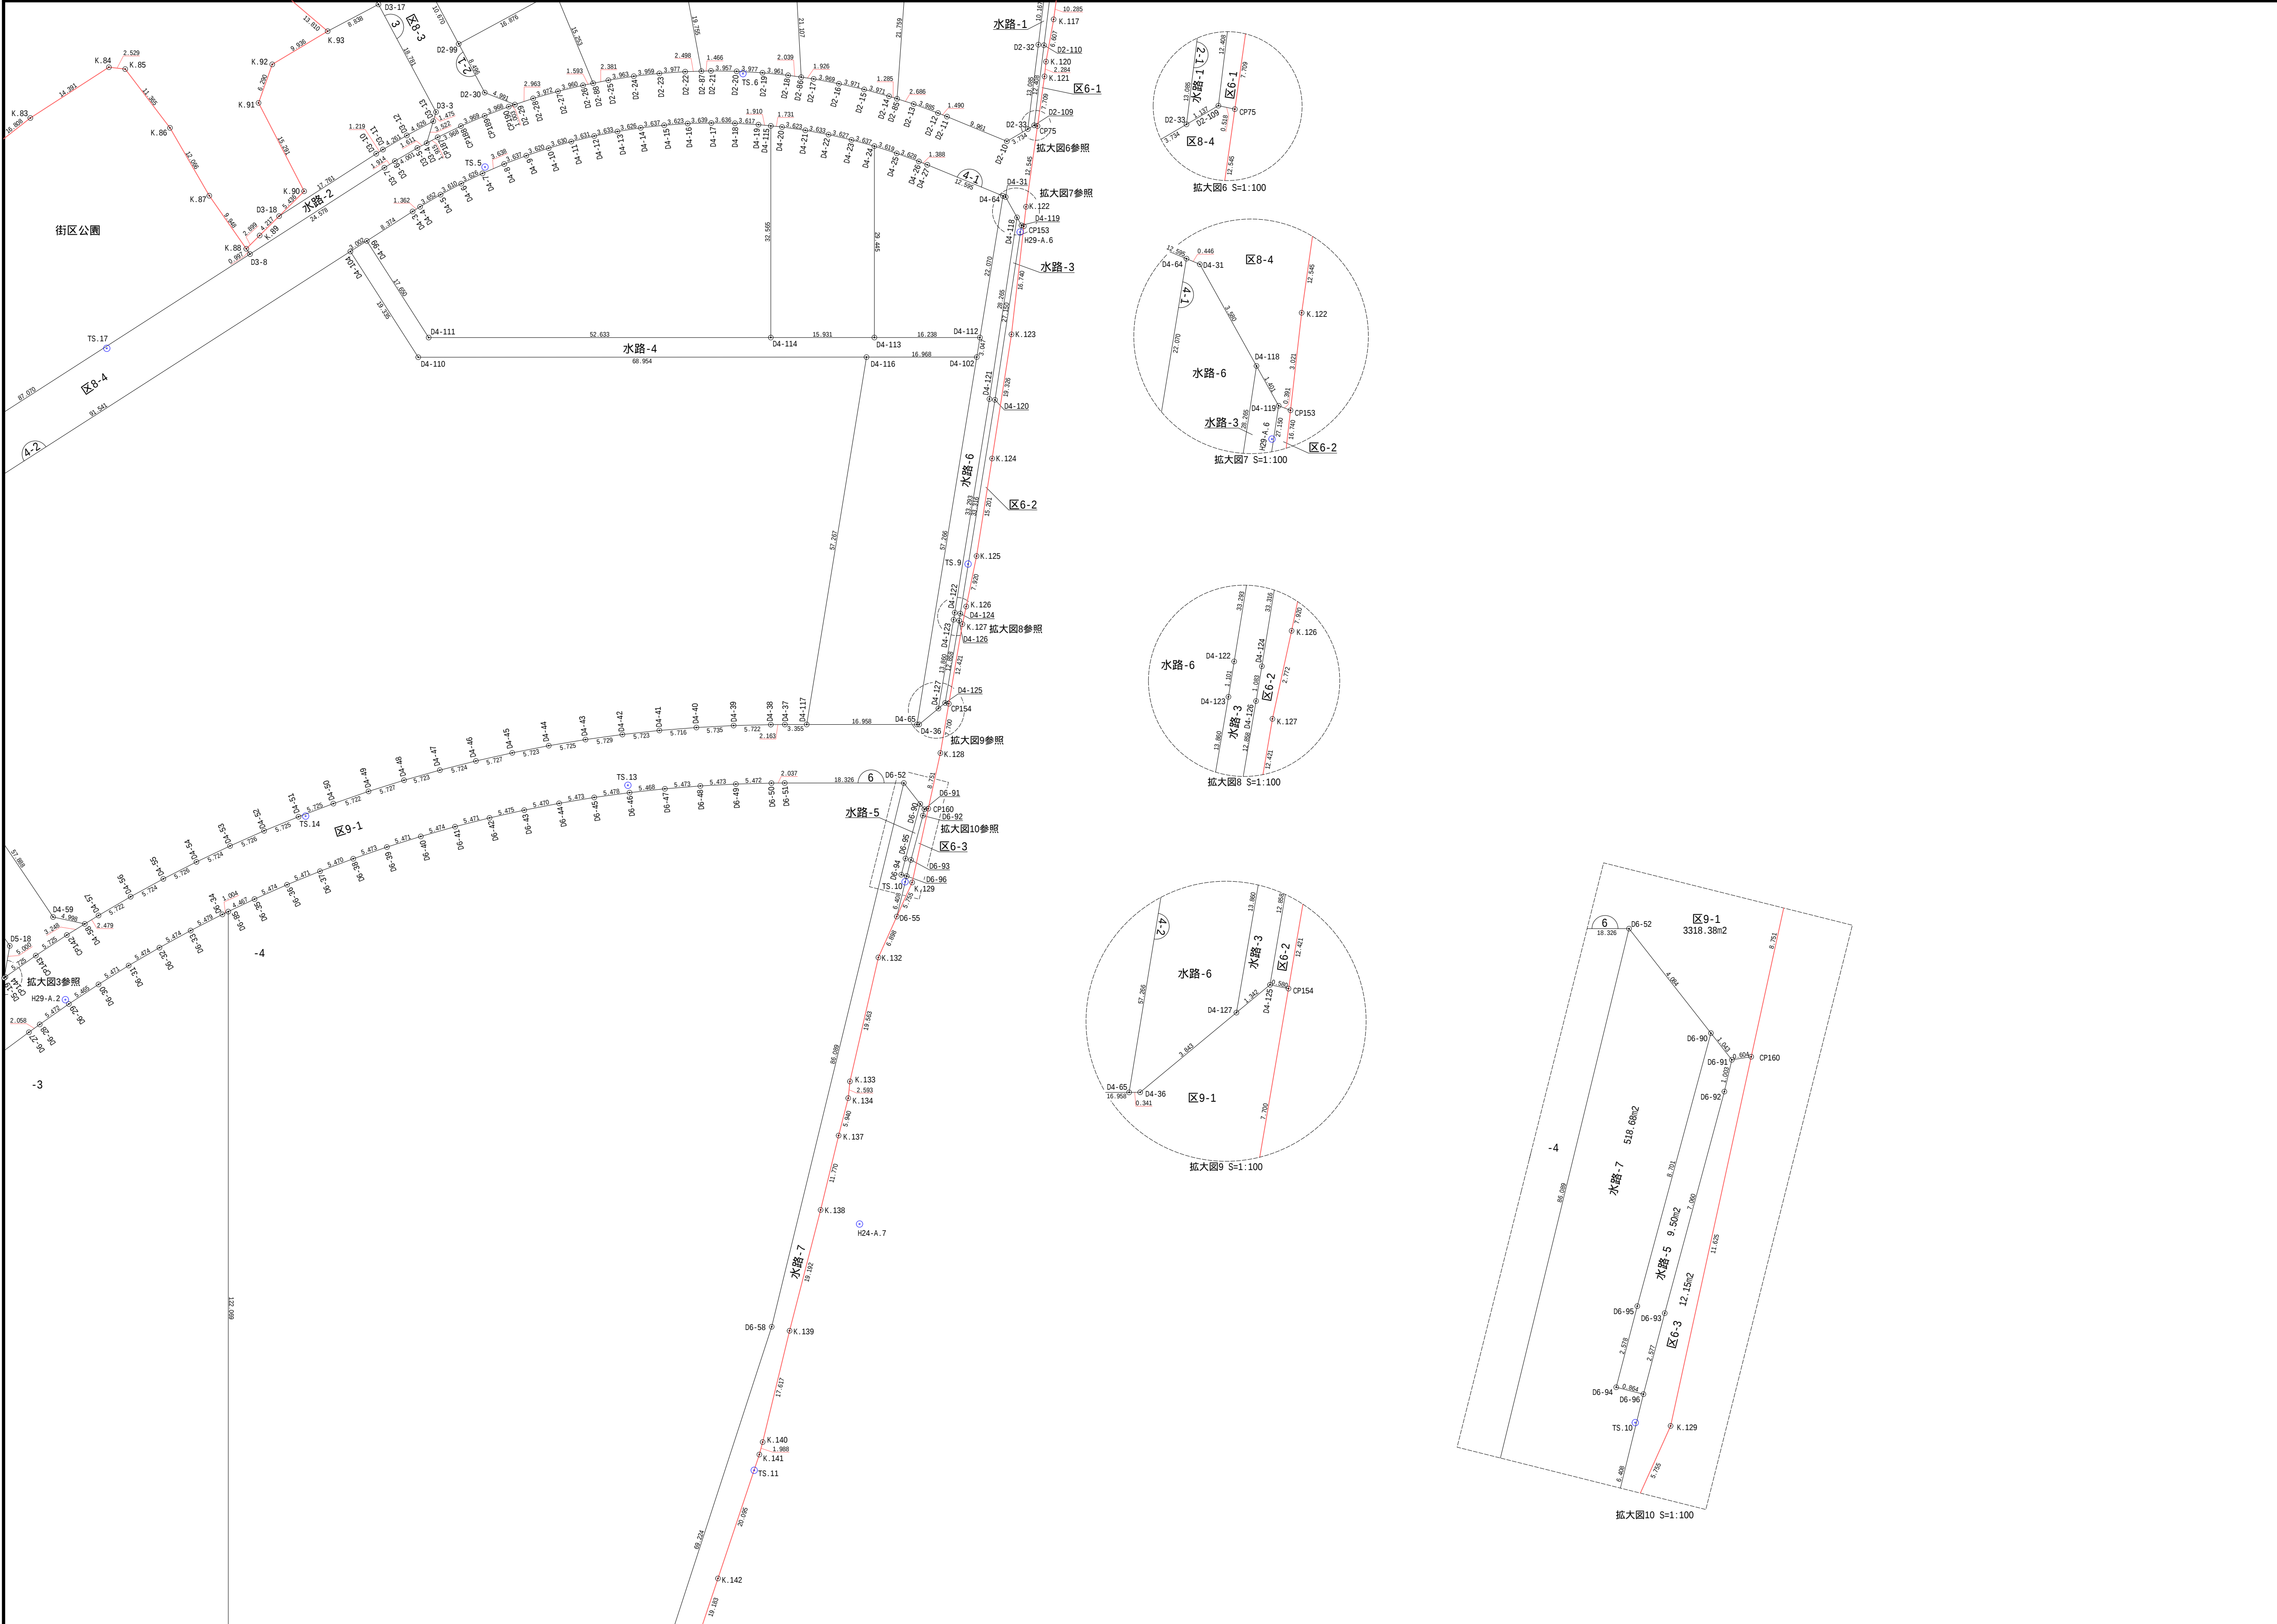

	1	
2	3	
4	5	


図面番号 KE64-20-21

佐野市

三立調査設計株式会社


X=34500.000

三立調査設計株式会社

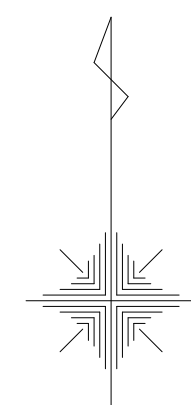


	2	3
	4	5

図面番号 KE64-10-35

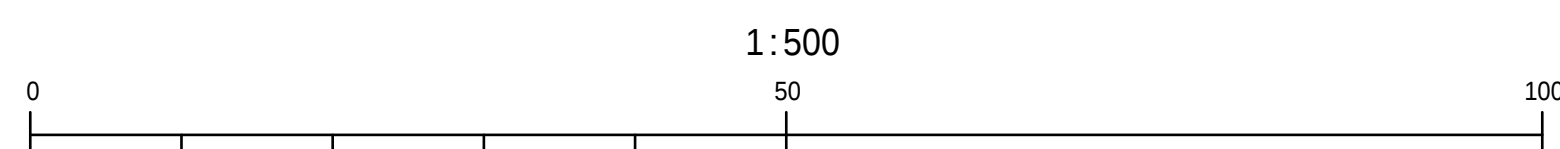

三立調査設計株式会社

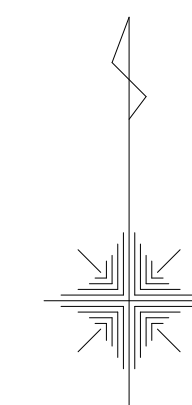

2	3	
4	5	

図面番号 KE64-20-31

