
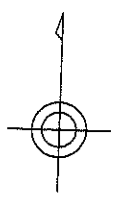


略 ☒ S = 1 / 2 5 0

街区面積 1,963.94 m²

画地面積 1,963.92 m²

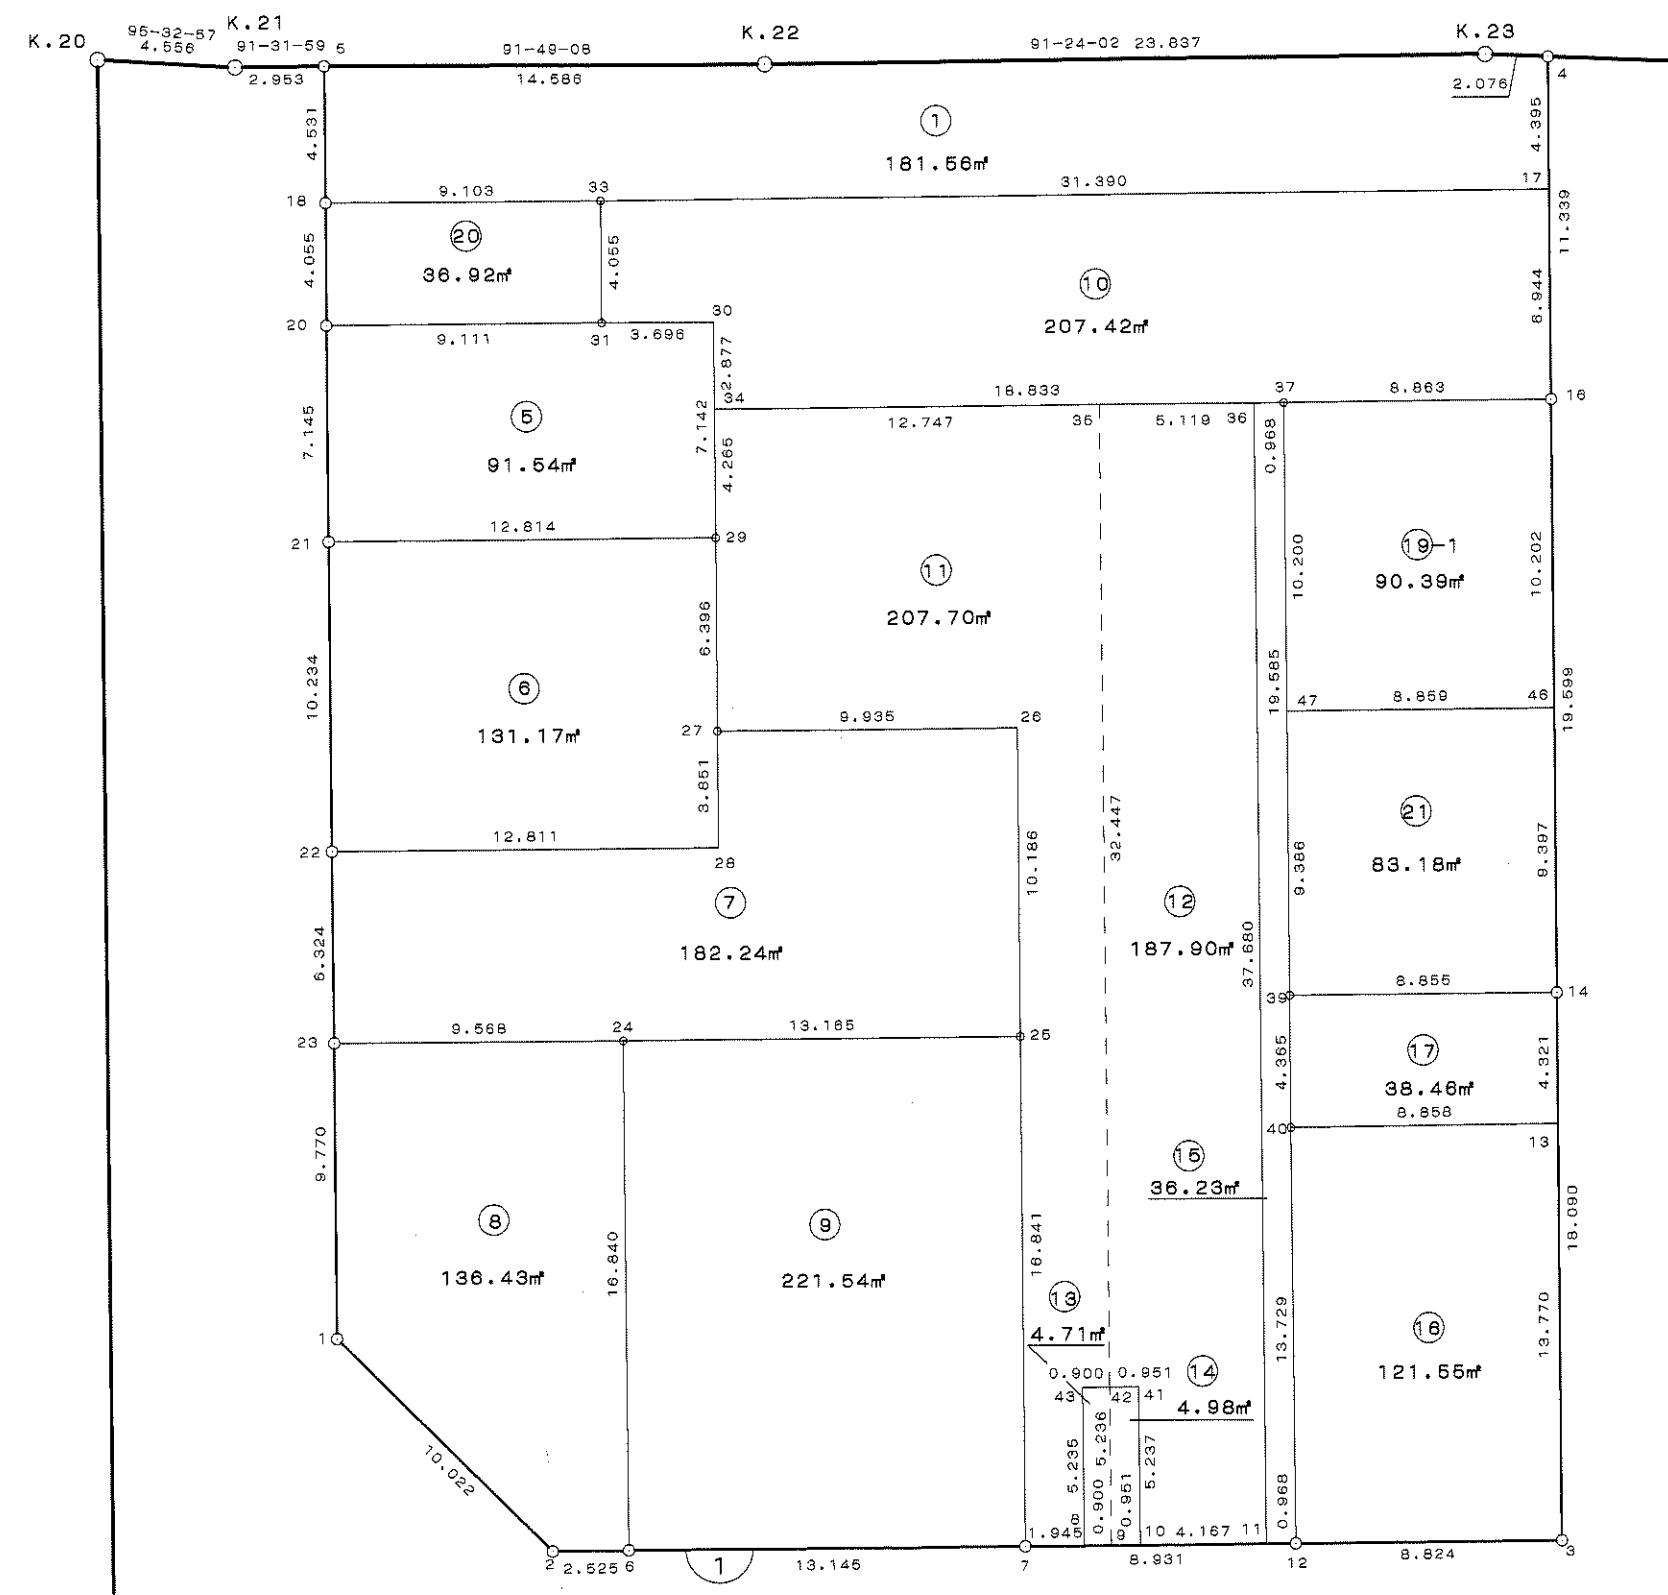

座標データリスト


現場名：佐野駅南地区 出来形

No	点 名	X	Y	No	点 名	X	Y
1	1B1	34740.1838884	-22775.5579368	26	1B 28	34755.9110715	-22762.3287024
2	1B2	34732.8923889	-22768.6821572	27	1B29	34766.1545565	-22762.0573484
3	1B3	34732.0104973	-22735.2695785	28	1B30	34773.2944791	-22761.8787857
4	1B4	34781.0214170	-22733.9702095	29	1B31	34773.4005653	-22765.5732674
5	1B 5	34782.2281417	-22774.4487379	30	1B33	34777.4536445	-22765.4637679
6	1B 6	34732.8312981	-22766.1578130	31	1B34	34770.4179562	-22761.9507249
7	1B7	34732.4786792	-22753.0177671	32	1B35	34770.0746020	-22749.2084415
8	1B8	34732.4274631	-22751.0738985	33	1B36	34769.9367232	-22744.0915978
9	1B9	34732.4037586	-22750.1742107	34	1B37	34769.9106597	-22743.1243511
10	1B10	34732.3787040	-22749.2232831	35	1B39	34750.3318371	-22743.6335962
11	1B11	34732.2689405	-22745.0572885	36	1B 40	34745.9685767	-22743.7537949
12	1B12	34732.2434556	-22744.0900270	37	1B41	34737.6136231	-22749.0890753
13	1B 13	34745.7753663	-22734.8979824	38	1B42	34737.6380032	-22750.0400201
14	1B14	34750.0943816	-22734.7813863	39	1B43	34737.6610694	-22750.9397208
15	1B16	34769.6866376	-22734.2641945	40	1B 46	34759.4881653	-22734.5334114
16	1B17	34776.6279422	-22734.0841610	41	1B 47	34759.7142166	-22743.3895606
17	1B18	34777.6980898	-22774.5631564	42	K. 22	34781.7652238	-22759.8705080
18	1B20	34773.6452481	-22774.6809813	43	K. 23	34781.1826410	-22736.0404203
19	1B21	34766.5028792	-22774.8666133				
20	1B 22	34756.2722386	-22775.1341144				
21	1B 23	34749.9502967	-22775.2930401				
22	1B 24	34749.6661989	-22765.7293093				
23	1B25	34749.3139787	-22752.5688967				
24	1B 26	34759.4962961	-22752.3021357				
25	1B 27	34759.7609851	-22762.2335611				

街区面積 2,924.95 m²

画地面積 2,924.94 m²

略 ☒ S = 1 / 250

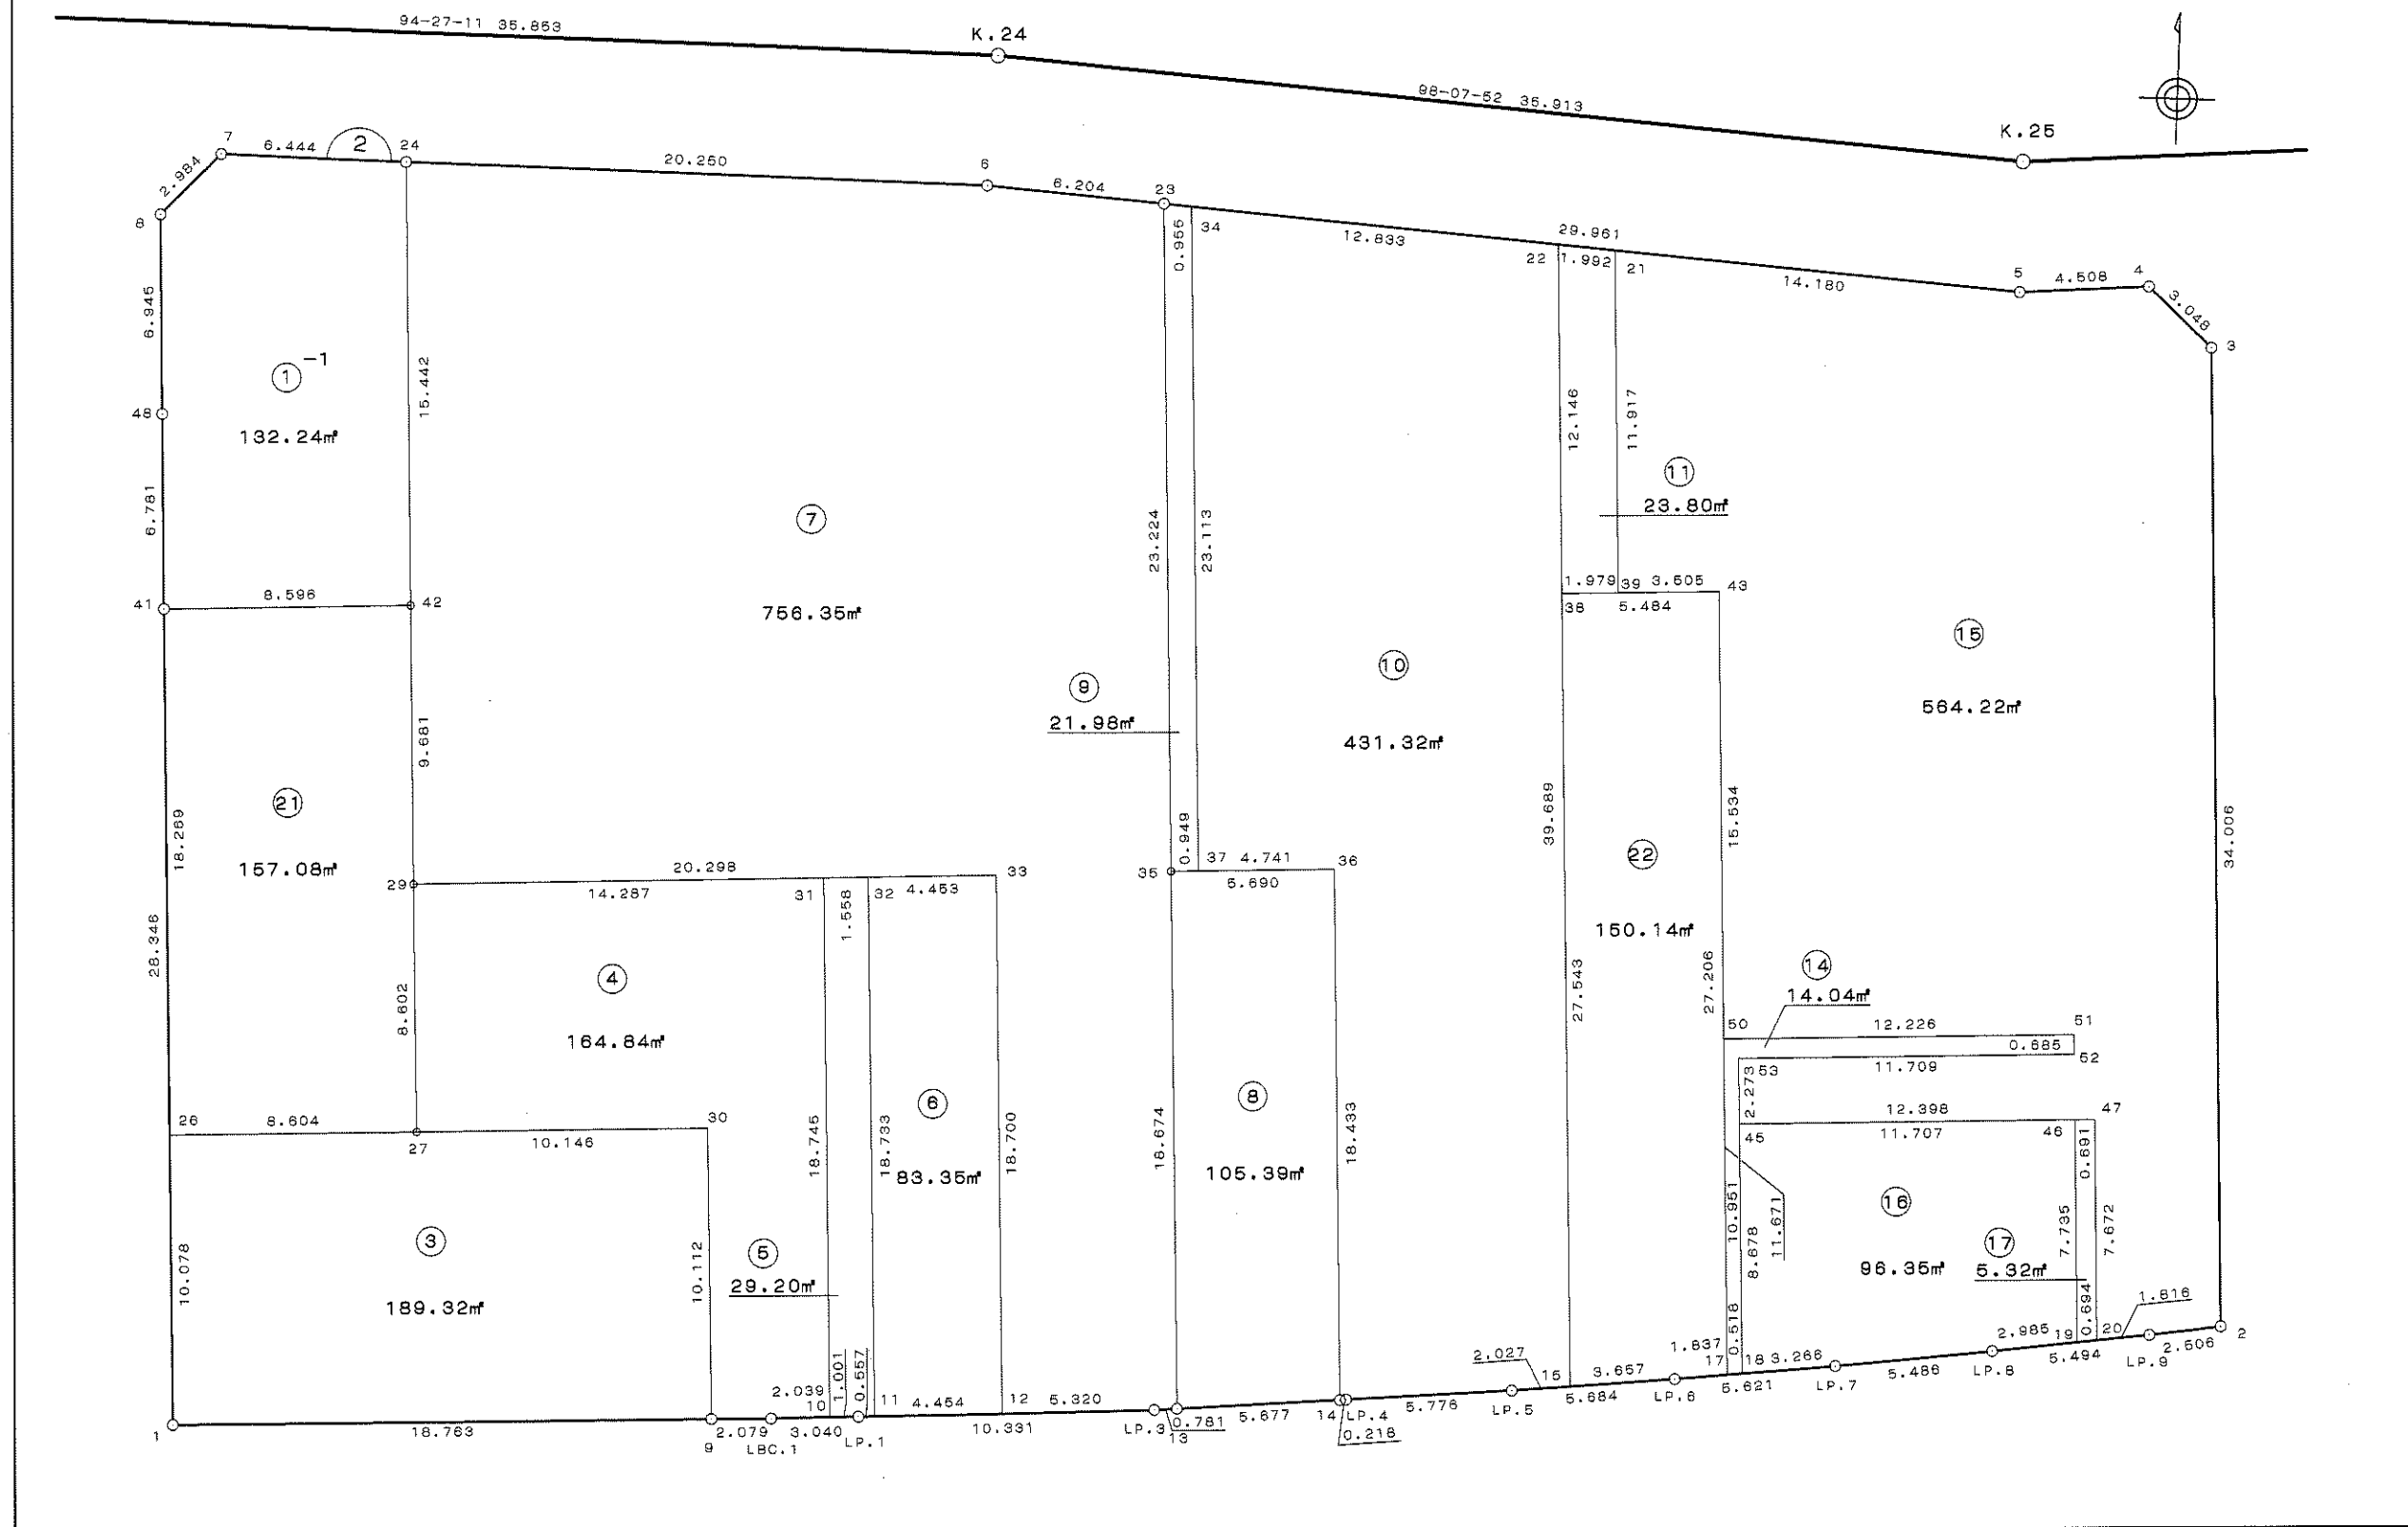

座標データリスト


現場名：佐野駅南地区 出来形

No	点 名	X	Y	No	点 名	X	Y	No	点 名	X	Y
1	2B1	34731.9164579	-22730.7639527	26	2B29	34750.3637838	-22721.6894825	51	LP.4	34731.2372493	-22689.8850805
2	2B2	34732.5880832	-22659.3540553	27	2B30	34741.5027789	-22711.7569466	52	LP.5	34731.3299157	-22684.1094331
3	2B3	34766.5815767	-22658.4271948	28	2B 31	34750.0363770	-22707.4065496	53	LP.6	34731.5125714	-22678.4287307
4	2B4	34768.7953148	-22660.5220729	29	2B 32	34750.0006656	-22705.8486586	54	LP.7	34731.7438195	-22672.8128898
5	2B5	34768.7864904	-22665.0300434	30	2B 33	34749.8986095	-22701.3965212	55	LP.8	34732.0425117	-22667.3346262
6	2B6	34773.8880503	-22700.8329207	31	2B 34	34772.8829791	-22693.7448305	56	LP.9	34732.3940356	-22661.8521773
7	2B7	34775.9983367	-22727.4426571	32	2B35	34749.8018173	-22695.2969454				
8	2B8	34773.9736285	-22729.6347443	33	2B36	34749.6591417	-22689.6090919				
9	2B9	34731.3936242	-22712.0083985	34	2B 37	34749.7780271	-22694.3485345				
10	2B 10	34731.2980773	-22707.8910475	35	2B 38	34758.9285738	-22681.3595691				
11	2B 11	34731.2734980	-22706.3328687	36	2B 39	34758.8765471	-22679.3816854				
12	2B 12	34731.2052452	-22701.8798573	37	2B41	34760.2529887	-22730.0238466				
13	2B13	34731.1342420	-22695.7796543	38	2B42	34760.0416048	-22721.4300066				
14	2B14	34731.2326679	-22690.1033813	39	2B 43	34758.7843818	-22675.8778683				
15	2B 15	34731.3950467	-22682.0838179	40	2B 45	34740.2846334	-22675.8479086				
16	2B 17	34731.5881527	-22676.5932448	41	2B 46	34739.9655543	-22664.1453761				
17	2B 18	34731.6094475	-22676.0761029	42	2B 47	34739.9467310	-22663.4550138				
18	2B 19	34732.2334827	-22664.3561974	43	2B48	34767.0313322	-22729.8298602				
19	2B 20	34732.2778579	-22663.6641119	44	2B 50	34743.2555923	-22676.2863415				
20	2B 21	34770.7892108	-22679.0683317	45	2B 51	34742.9223607	-22664.0647563				
21	2B 22	34771.0705178	-22681.0401844	46	2B 52	34742.2375257	-22664.0834289				
22	2B23	34773.0178665	-22694.6903385	47	2B 53	34742.5566644	-22675.7881446				
23	2B24	34775.4779958	-22721.0199183	48	LBC.1	34731.3307475	-22709.9299591				
24	2B 26	34741.9906298	-22730.5008310	49	LP.1	34731.2820412	-22706.8902484				
25	2B27	34741.7640260	-22721.8995872	50	LP.3	34731.1237107	-22696.5603025				

略 ☒ S = 1 / 250

街区面積 1,768.04 m²

画地面積 1,768.00 m²

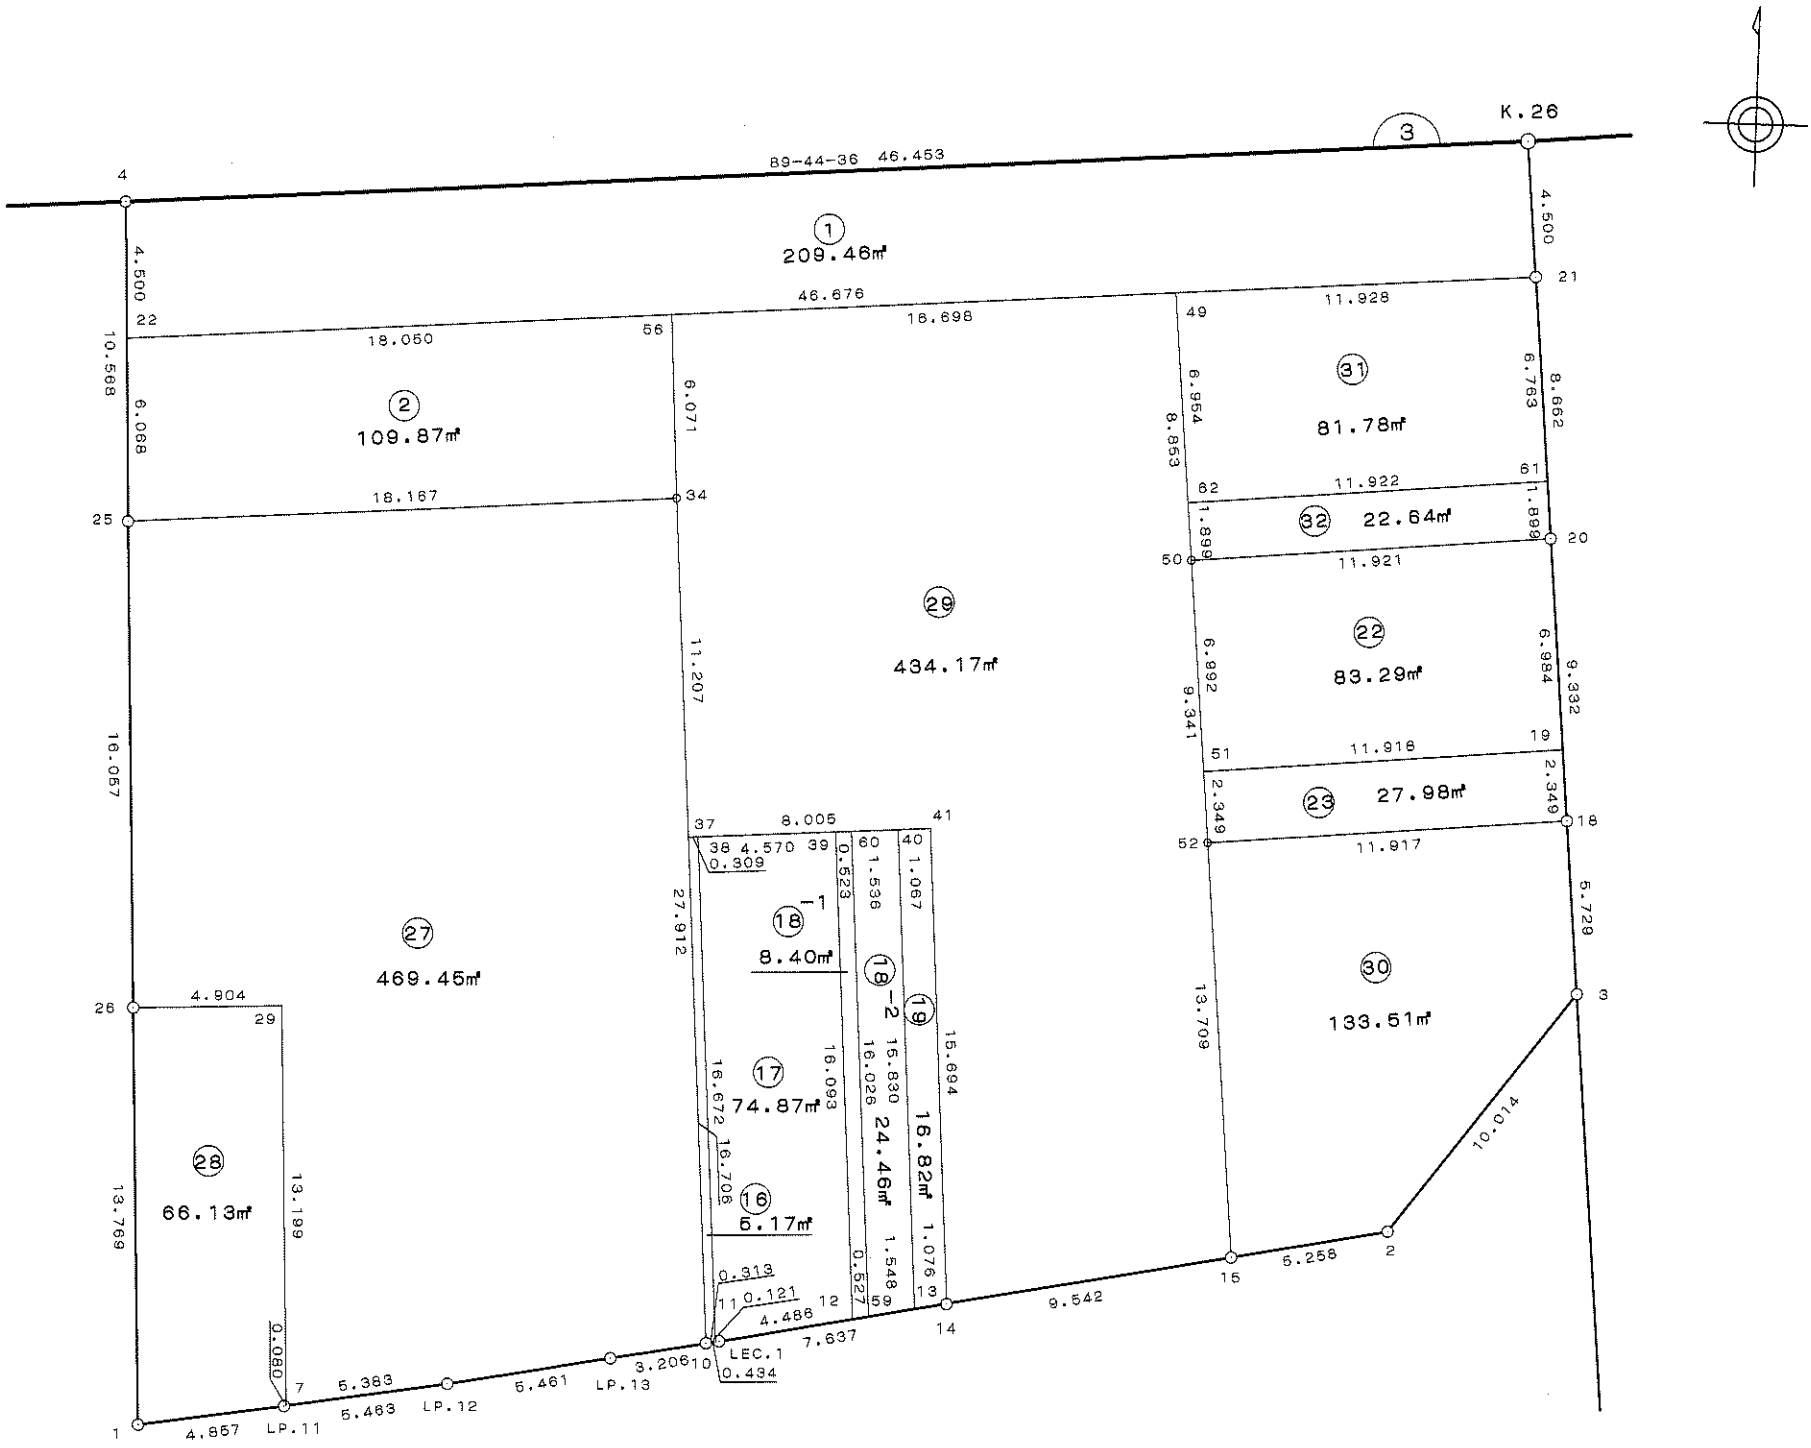

座標データリスト



現場名：佐野駅南地区 出来形

No	点 名	X	Y	No	点 名	X	Y
1	3B1	34732.9480506	-22654.8416241	26	3B 49	34768.9825992	-22619.1298532
2	3B2	34737.7351857	-22613.2615099	27	3B50	34760.1312044	-22618.9446171
3	3B3	34745.3166584	-22606.7188524	28	3B 51	34753.1404198	-22618.8016852
4	3B4	34773.3264756	-22653.7452339	29	3B52	34750.7923046	-22618.7536763
5	3B 7	34733.3899855	-22649.9241281	30	3B 56	34768.9085051	-22635.8280147
6	3B 10	34734.9258695	-22635.9585517	31	3B 59	34735.5947335	-22630.5528667
7	3B 11	34734.9585410	-22635.6473096	32	3B 60	34751.6205817	-22630.5144272
8	3B 12	34735.5291414	-22631.0760946	33	3B 61	34762.2742673	-22607.0649664
9	3B 13	34735.7873025	-22629.0167431	34	3B 62	34762.0302794	-22618.9843596
10	3B14	34735.9211168	-22627.9493064	35	K. 26	34773.5345965	-22607.2931280
11	3B15	34737.0859115	-22618.4789193	36	LEC. 1	34734.9711484	-22635.5272060
12	3B18	34751.0448384	-22606.8394247	37	LP. 11	34733.3823163	-22650.0036341
13	3B 19	34753.3929727	-22606.8865302	38	LP. 12	34733.9068527	-22644.5658398
14	3B20	34760.3751642	-22607.0265984	39	LP. 13	34734.5370959	-22639.1412359
15	3B 21	34769.0355281	-22607.2015655				
16	3B 22	34768.8284155	-22653.8773509				
17	3B25	34762.7631919	-22654.0554987				
18	3B26	34746.7120600	-22654.4832761				
19	3B 29	34746.5844184	-22649.5806092				
20	3B 34	34762.8379374	-22635.8882416				
21	3B 37	34751.6313223	-22635.9164709				
22	3B 38	34751.6307077	-22635.6073200				
23	3B 39	34751.6216217	-22631.0374953				
24	3B 40	34751.6175285	-22628.9787728				
25	3B41	34751.6154068	-22627.9116623				

S = 1 / 250

街区面積 4,254.88 m²


画地面積 4,254.78 m²

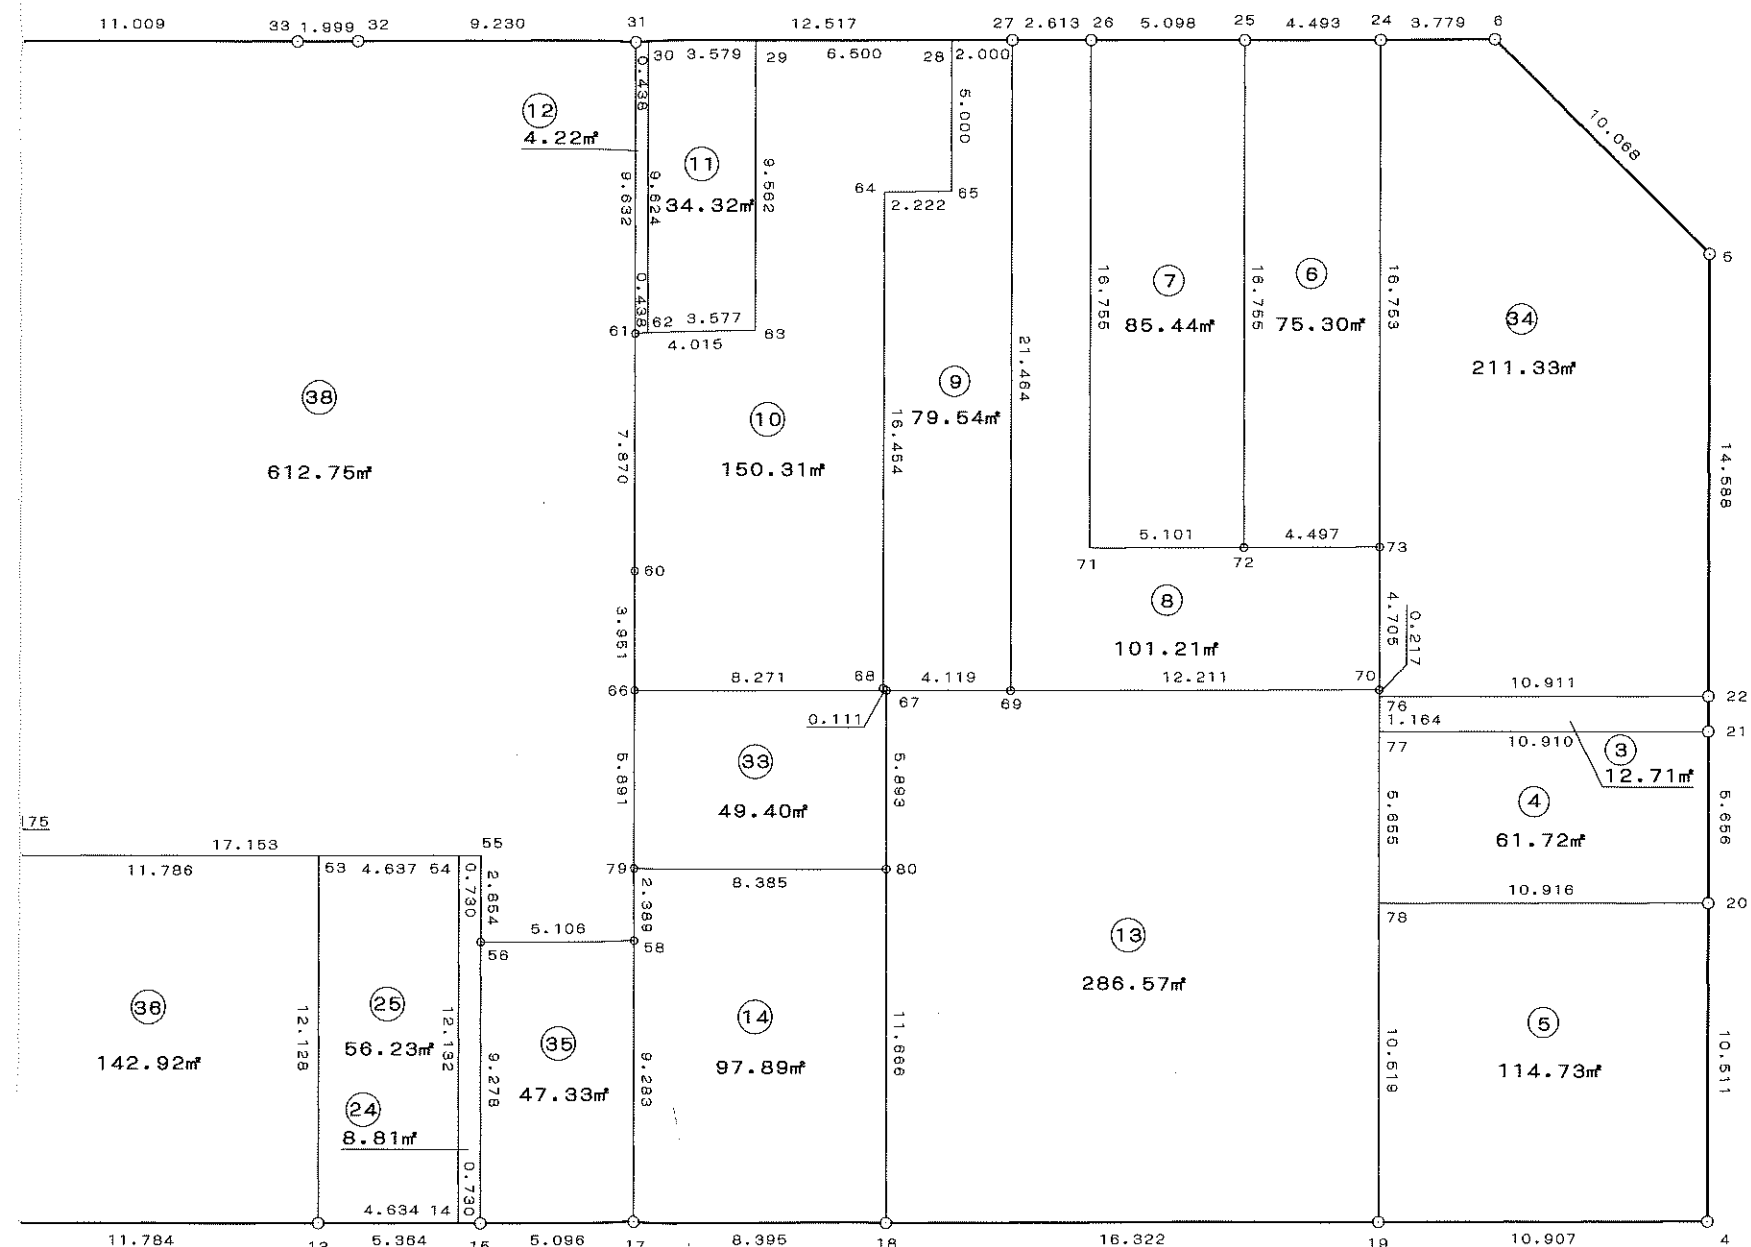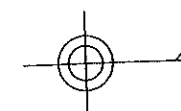

4B

②

略

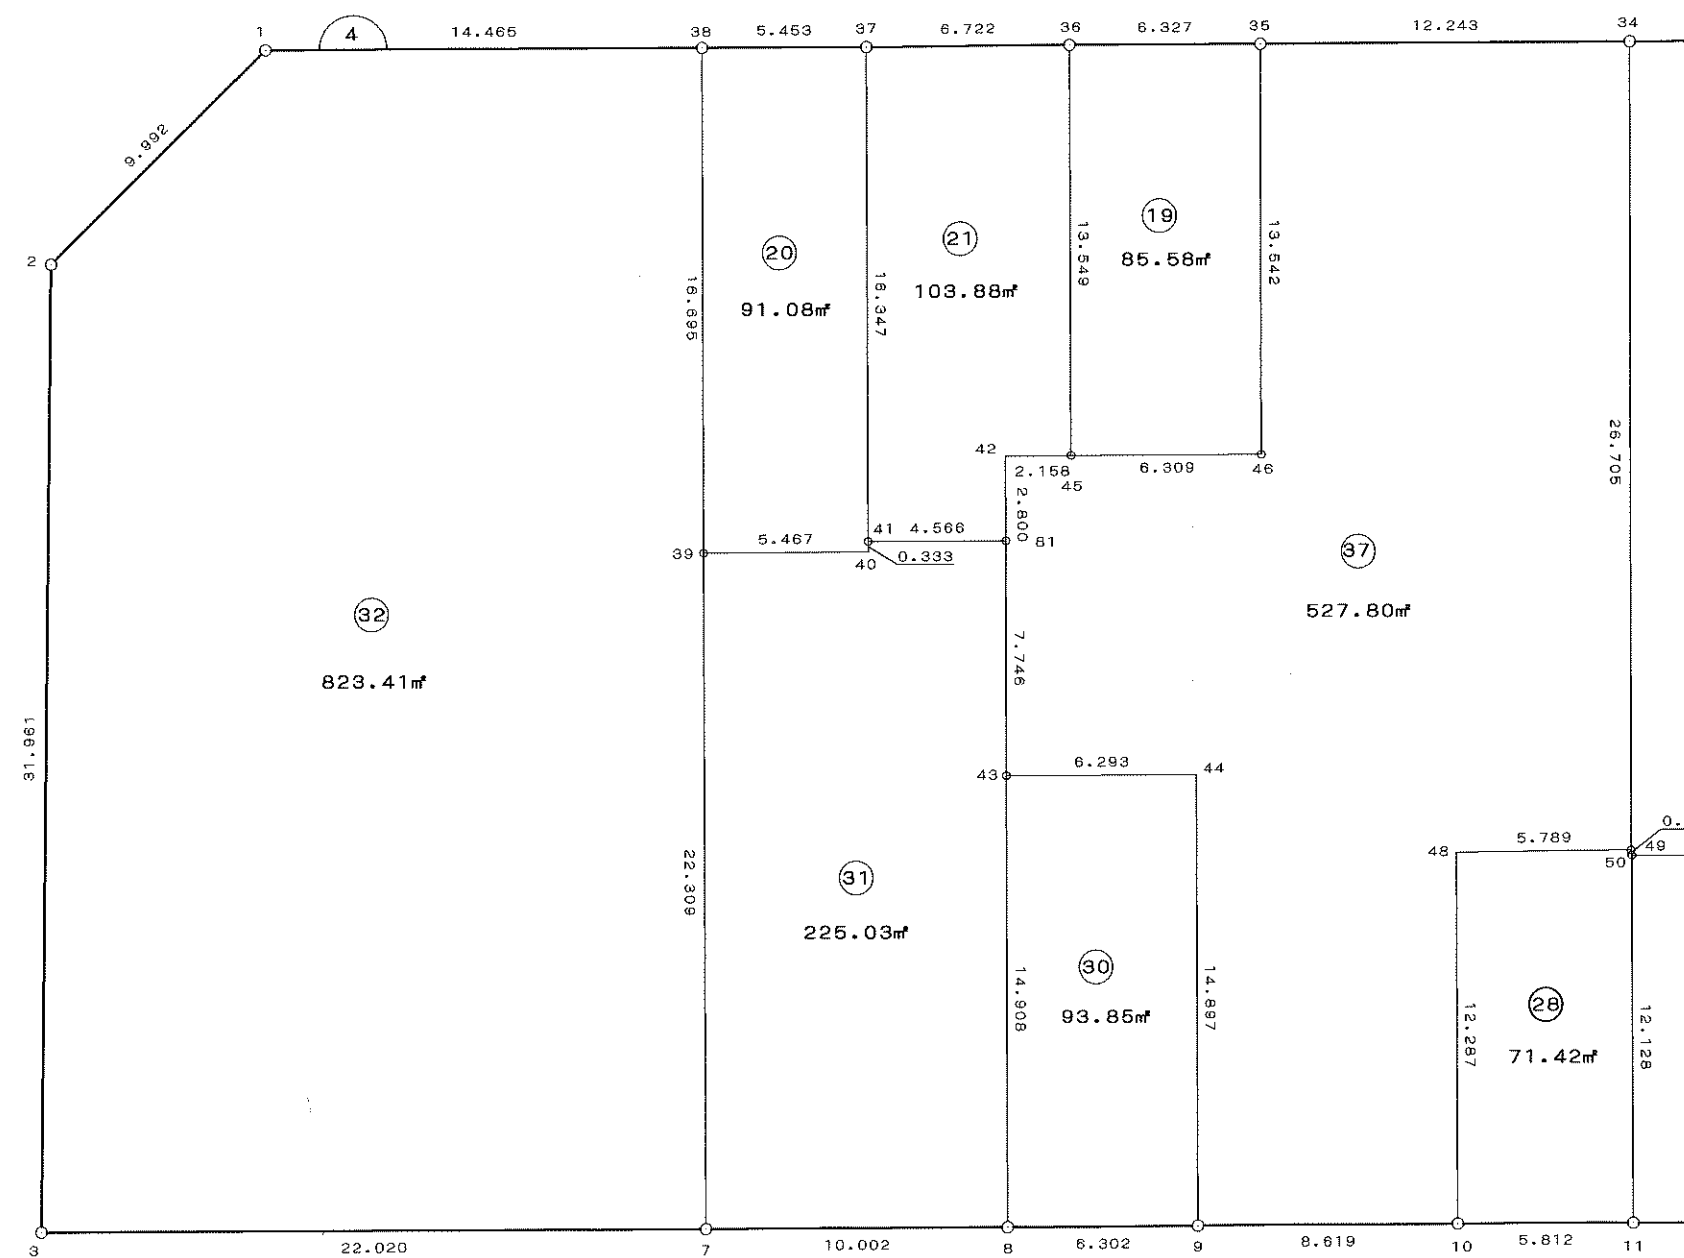

座標データリスト



現場名：佐野駅南地区 出来形

No	点 名	X	Y	No	点 名	X	Y	No	点 名	X	Y
1	4B1	34615.0341865	-22778.8439611	26	4B 29	34686.4744187	-22776.9755917	51	4B58	34681.6866680	-22747.3576387
2	4B2	34607.7397126	-22772.0157878	27	4B 30	34682.8966583	-22777.0691600	52	4B60	34682.0071396	-22759.5844401
3	4B3	34606.4683065	-22740.0802237	28	4B31	34682.4585027	-22777.0806190	53	4B61	34682.2096340	-22767.4518346
4	4B4	34717.0526296	-22737.1497203	29	4B32	34673.2317876	-22777.3145652	54	4B 62	34682.6479866	-22767.4479967
5	4B5	34717.8993907	-22769.0602690	30	4B33	34671.2333364	-22777.3675960	55	4B 63	34686.2244269	-22767.4166837
6	4B6	34710.9487046	-22776.3435159	31	4B34	34660.2285120	-22777.6578298	56	4B 64	34690.6203078	-22771.8654557
7	4B7	34628.4796660	-22739.4755328	32	4B35	34647.9895306	-22777.9776747	57	4B 65	34692.8414778	-22771.8073660
8	4B8	34638.4783390	-22739.2116644	33	4B36	34641.6646717	-22778.1465335	58	4B66	34681.9057662	-22755.6347408
9	4B9	34644.7784942	-22739.0460209	34	4B37	34634.9450670	-22778.3243271	59	4B67	34690.2847892	-22755.4131770
10	4B10	34653.3946361	-22738.8188900	35	4B38	34629.4941392	-22778.4663884	60	4B68	34690.1736016	-22755.4175647
11	4B11	34659.2047746	-22738.6646119	36	4B39	34629.0583287	-22761.7770777	61	4B69	34694.4021622	-22755.2966199
12	4B13	34670.9848060	-22738.3562389	37	4B40	34634.5237492	-22761.6494080	62	4B70	34706.6092146	-22754.9870141
13	4B 14	34675.6171238	-22738.2312013	38	4B41	34634.5290626	-22761.9821765	63	4B71	34697.1379741	-22759.9316289
14	4B15	34676.3464459	-22738.2115152	39	4B42	34639.1653717	-22764.6563908	64	4B72	34702.2376218	-22759.8043918
15	4B17	34681.4402584	-22738.0783212	40	4B43	34638.8800005	-22754.1142525	65	4B73	34706.7329165	-22759.6903877
16	4B18	34689.8329169	-22737.8601721	41	4B44	34645.1709768	-22753.9374565	66	4B76	34706.6035342	-22754.7700884
17	4B19	34706.1496782	-22737.4380297	42	4B45	34641.3225423	-22764.6018538	67	4B77	34706.5730642	-22753.6064873
18	4B20	34717.3375132	-22747.6572884	43	4B46	34647.6296607	-22764.4404572	68	4B78	34706.4250336	-22747.9534251
19	4B21	34717.4792389	-22753.3118600	44	4B48	34653.7150237	-22751.1019467	69	4B79	34681.7500089	-22749.7457992
20	4B22	34717.5107542	-22754.4774443	45	4B49	34659.5022446	-22750.9624242	70	4B80	34690.1315574	-22749.5220700
21	4B24	34707.1709365	-22776.4381402	46	4B50	34659.5169378	-22750.7885115	71	4B81	34639.0928706	-22761.8573277
22	4B25	34702.6797083	-22776.5535585	47	4B 53	34671.2987934	-22750.4801003				
23	4B26	34697.5833037	-22776.6807100	48	4B 54	34675.9345973	-22750.3587498				
24	4B27	34694.9715133	-22776.7533693	49	4B55	34676.6639350	-22750.3396580				
25	4B 28	34692.9721969	-22776.8056569	50	4B56	34676.5824603	-22747.4868803				

略 ☒ S = 1 / 250

街区面積 2,394.95 m²

画地面積 2,394.88 m²

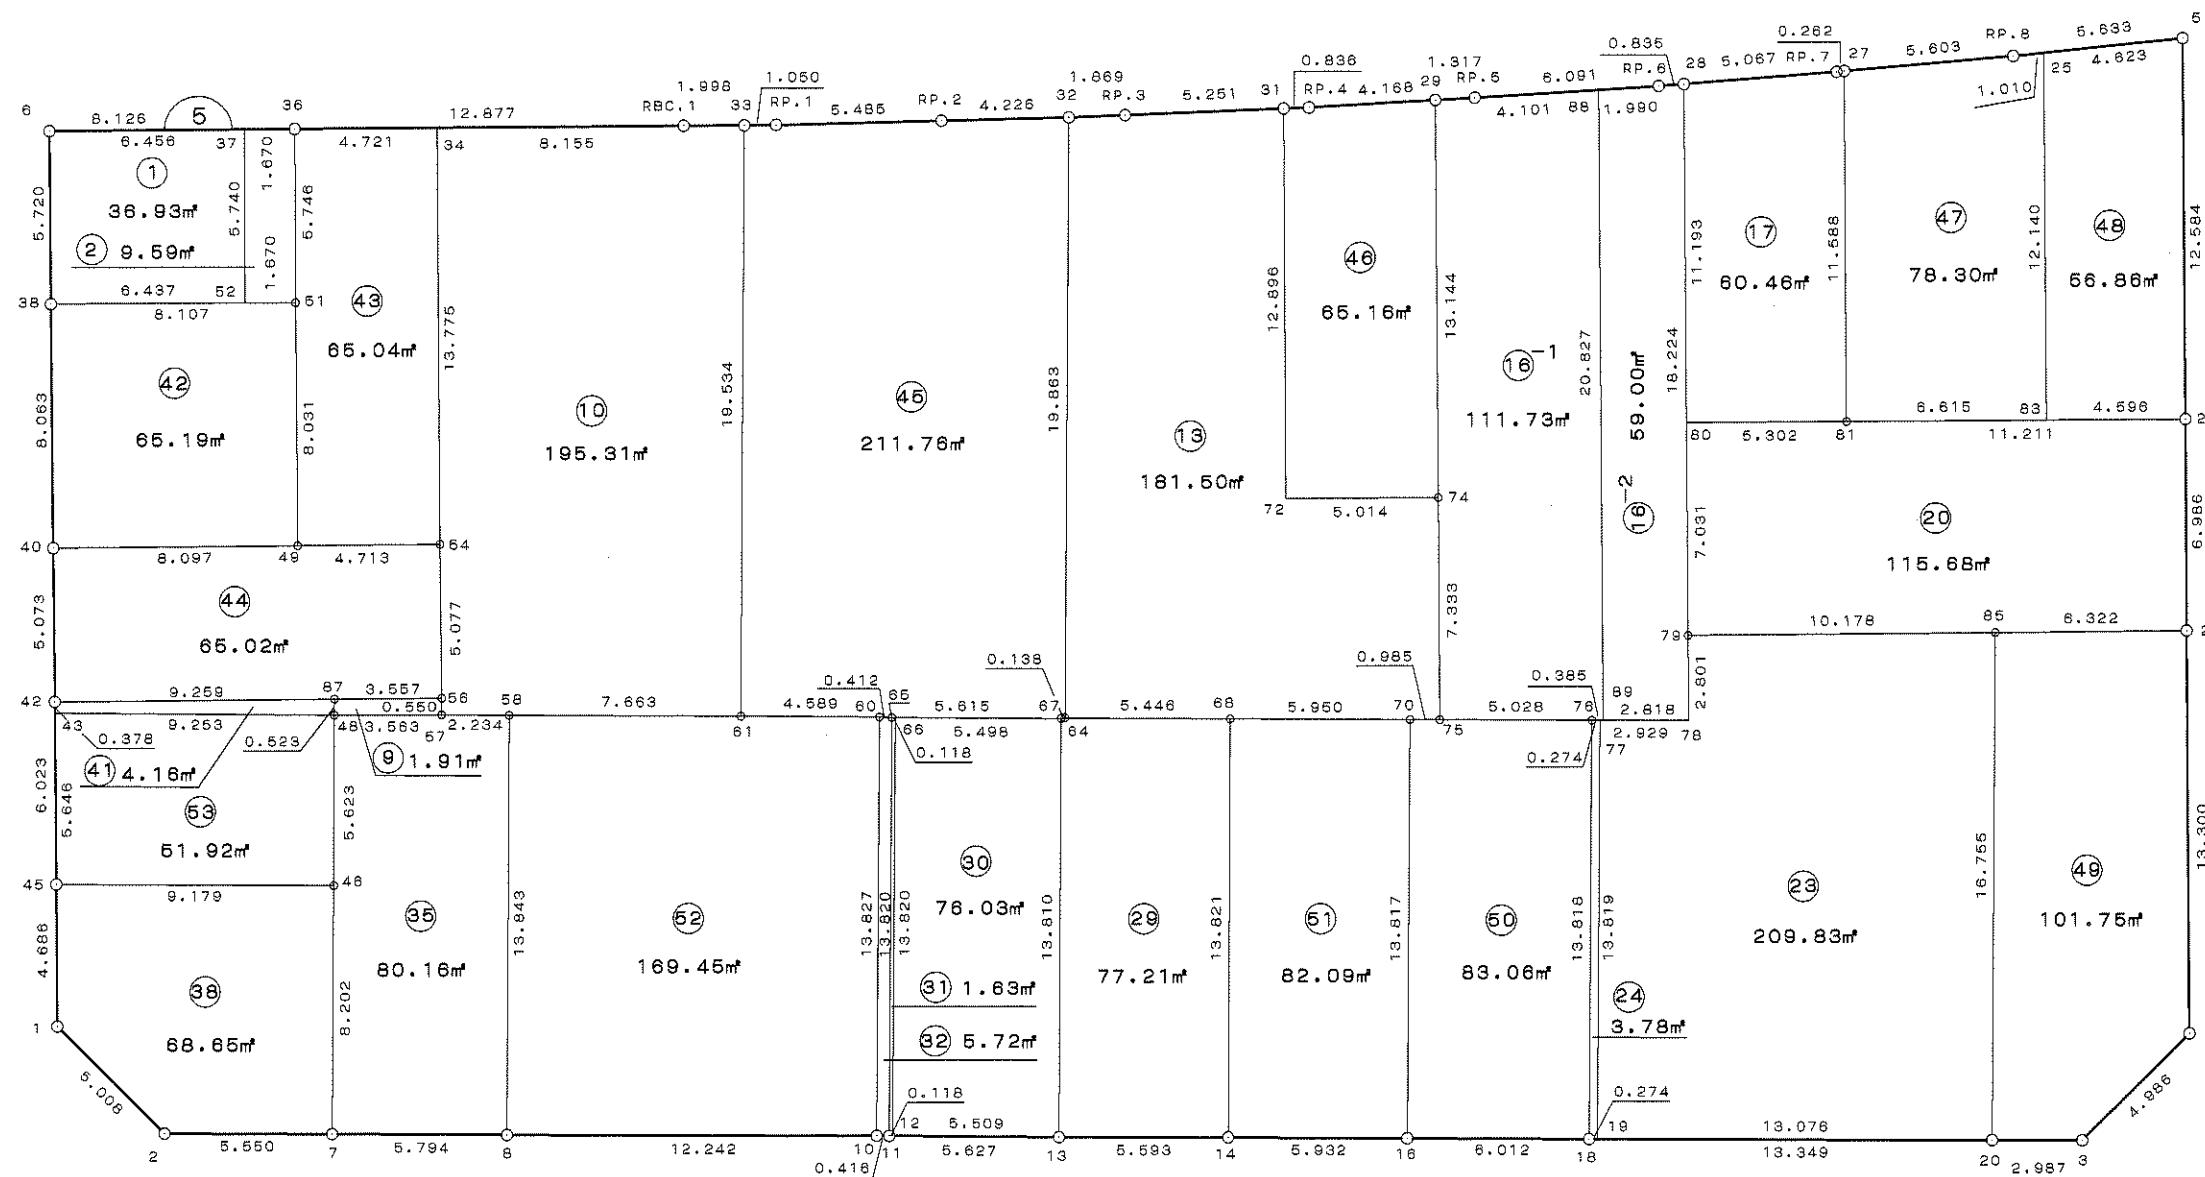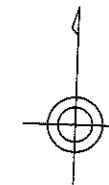

座標データリスト



現場名：佐野駅南地区 出来形

No	点 名	X	Y	No	点 名	X	Y	No	点 名	X	Y
1	5B1	34687.3725176	-22731.9333224	26	5B33	34716.3090598	-22708.1920114	51	5B70	34695.8869828	-22686.8339905
2	5B2	34683.7149648	-22728.5127937	27	5B34	34716.5827982	-22718.3414610	52	5B72	34703.3233027	-22690.6664993
3	5B3	34681.1989919	-22665.0622130	28	5B36	34716.7103348	-22723.0610815	53	5B74	34703.1743537	-22685.6546550
4	5B4	34684.5963316	-22661.4134359	29	5B37	34716.7549640	-22724.7302951	54	5B75	34695.8439588	-22685.8501113
5	5B5	34717.4543446	-22660.5286604	30	5B38	34711.2096973	-22731.3288007	55	5B76	34695.6515482	-22680.8255997
6	5B6	34716.9275093	-22731.1838098	31	5B40	34703.1492528	-22731.5280067	56	5B77	34695.6411830	-22680.5522503
7	5B7	34683.4971726	-22722.9673777	32	5B42	34698.0782125	-22731.6507158	57	5B78	34695.5301802	-22677.6249000
8	5B8	34683.2658027	-22717.1784024	33	5B43	34697.7007819	-22731.6604973	58	5B79	34698.3301396	-22677.5485198
9	5B10	34682.7853673	-22704.9462990	34	5B45	34692.0571043	-22731.8067594	59	5B80	34705.3591701	-22677.3631741
10	5B 11	34682.7651008	-22704.5309578	35	5B46	34691.6923773	-22722.6351386	60	5B 81	34705.1995574	-22672.0637458
11	5B12	34682.7603058	-22704.4131097	36	5B48	34697.3107342	-22722.4158487	61	5B 83	34705.0078351	-22665.4512918
12	5B13	34682.5363237	-22698.9082445	37	5B49	34702.9381243	-22723.4337598	62	5B 85	34698.0570500	-22667.3738560
13	5B 14	34682.3177445	-22693.3198463	38	5B51	34710.9667871	-22723.2254407	63	5B87	34697.8337014	-22722.3954368
14	5B16	34682.0814220	-22687.3930321	39	5B52	34711.0168196	-22724.8944996	64	5B 88	34716.4570020	-22679.8917658
15	5B18	34681.8444631	-22681.3858391	40	5B54	34702.8130603	-22718.7224191	65	5B 89	34695.6369555	-22680.4407613
16	5B19	34681.8336245	-22681.1125089	41	5B56	34697.7373524	-22718.8393081	66	RBC.1	34716.3624984	-22710.1890498
17	5B 20	34681.3155352	-22668.0471700	42	5B57	34697.1879616	-22718.8546941	67	RP.1	34716.2795758	-22707.1424775
18	5B22	34697.8910050	-22661.0536960	43	5B58	34697.0975452	-22716.6225209	68	RP.2	34716.2193831	-22701.6575374
19	5B 23	34704.8746353	-22660.8572625	44	5B60	34696.6009384	-22704.3805793	69	RP.3	34716.1904772	-22695.5625977
20	5B 25	34717.1440194	-22665.1413938	45	5B61	34696.7902757	-22708.9656795	70	RP.4	34716.2242008	-22689.4753079
21	5B27	34716.7831826	-22671.7446744	46	5B64	34696.3323265	-22698.2216952	71	RP.5	34716.3413014	-22683.9907035
22	5B28	34716.5478073	-22677.0681454	47	5B 65	34696.5739851	-22703.9695883	72	RP.6	34716.5131584	-22677.9023063
23	5B29	34716.3137781	-22685.3078681	48	5B66	34696.5689740	-22703.8517490	73	RP.7	34716.7696589	-22672.0065040
24	5B31	34716.2144175	-22690.3115683	49	5B67	34696.3354038	-22698.3591809	74	RP.8	34717.0762358	-22666.1489426
25	5B32	34716.1797221	-22697.4312864	50	5B 68	34696.1282789	-22692.7790757				

略 図 S = 1 : 2 5 0

街区面積 1,703.12 m²

画地面積 1,703.08 m²

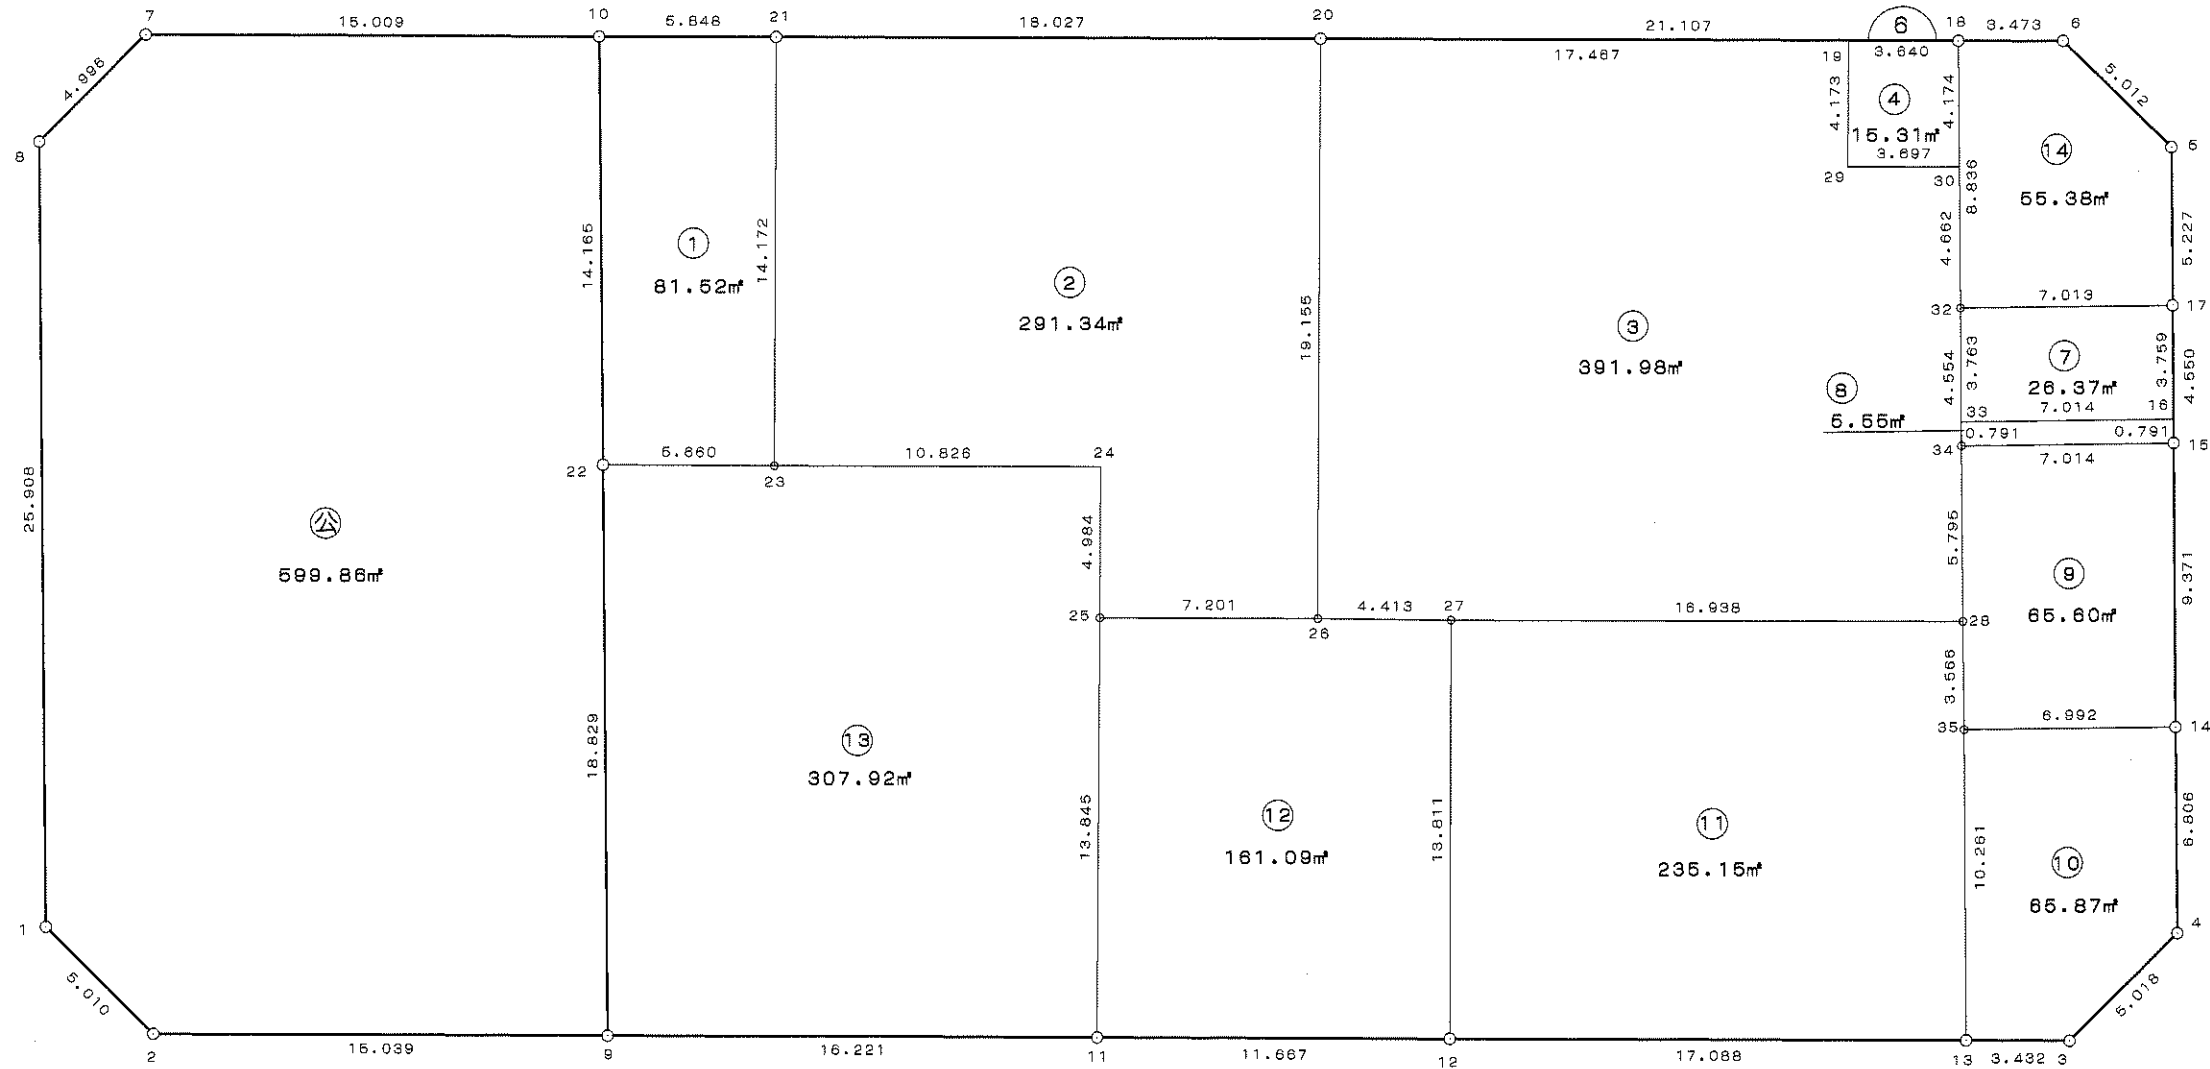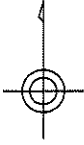

座標データリスト

現場名：佐野駅南地区 出来形



No	点 名	X	Y
1	6B3	34642.2003567	-22666.1455660
2	6B4	34645.6189717	-22662.4716887
3	6B5	34671.5638641	-22661.7781924
4	6B6	34675.2028082	-22665.2244939
5	6B9	34644.1388297	-22714.5146613
6	6B10	34677.1208539	-22713.6405410
7	6B 11	34643.4873616	-22698.3071949
8	6B12	34643.0214964	-22686.6491825
9	6B13	34642.3406839	-22669.5749415
10	6B14	34652.4227561	-22662.2977683
11	6B15	34661.7904167	-22662.0397765
12	6B16	34662.5813638	-22662.0176190
13	6B17	34666.3385738	-22661.9123650
14	6B18	34675.3408053	-22668.6945581
15	6B19	34675.4847456	-22672.3317110
16	6B20	34676.1754442	-22689.7846204
17	6B21	34676.8892570	-22707.7973700
18	6B22	34662.9605585	-22714.0055875
19	6B23	34662.7280466	-22708.3502754
20	6B24	34662.2999986	-22697.5331283
21	6B25	34657.3198452	-22697.7296320
22	6B26	34657.0351288	-22690.5343221
23	6B27	34656.8221831	-22686.1264629
24	6B28	34656.1622896	-22669.2016500
25	6B29	34671.3146460	-22672.4967426

No	点 名	X	Y
26	6B30	34671.1684508	-22668.8026130
27	6B32	34666.5076263	-22668.9233183
28	6B33	34662.7463359	-22669.0298204
29	6B34	34661.9553944	-22669.0522161
30	6B 35	34652.5976934	-22669.2879184
31	6B 36	34643.1013626	-22688.6477887
32	6B 37	34643.0814051	-22688.1483631
33	6B 38	34643.0614416	-22687.6487869
34	6B 39	34643.0414720	-22687.1490601
35	6B 40	34656.9187062	-22688.1244382
36	6B 41	34656.8945863	-22687.6251702
37	6B 42	34656.8704592	-22687.1257518
38	6B 43	34656.8463248	-22686.6261827

略 ☒ S = 1 / 2 5 0

街区面積 3, 148.31 m²

画地面積 3, 148.26 m²

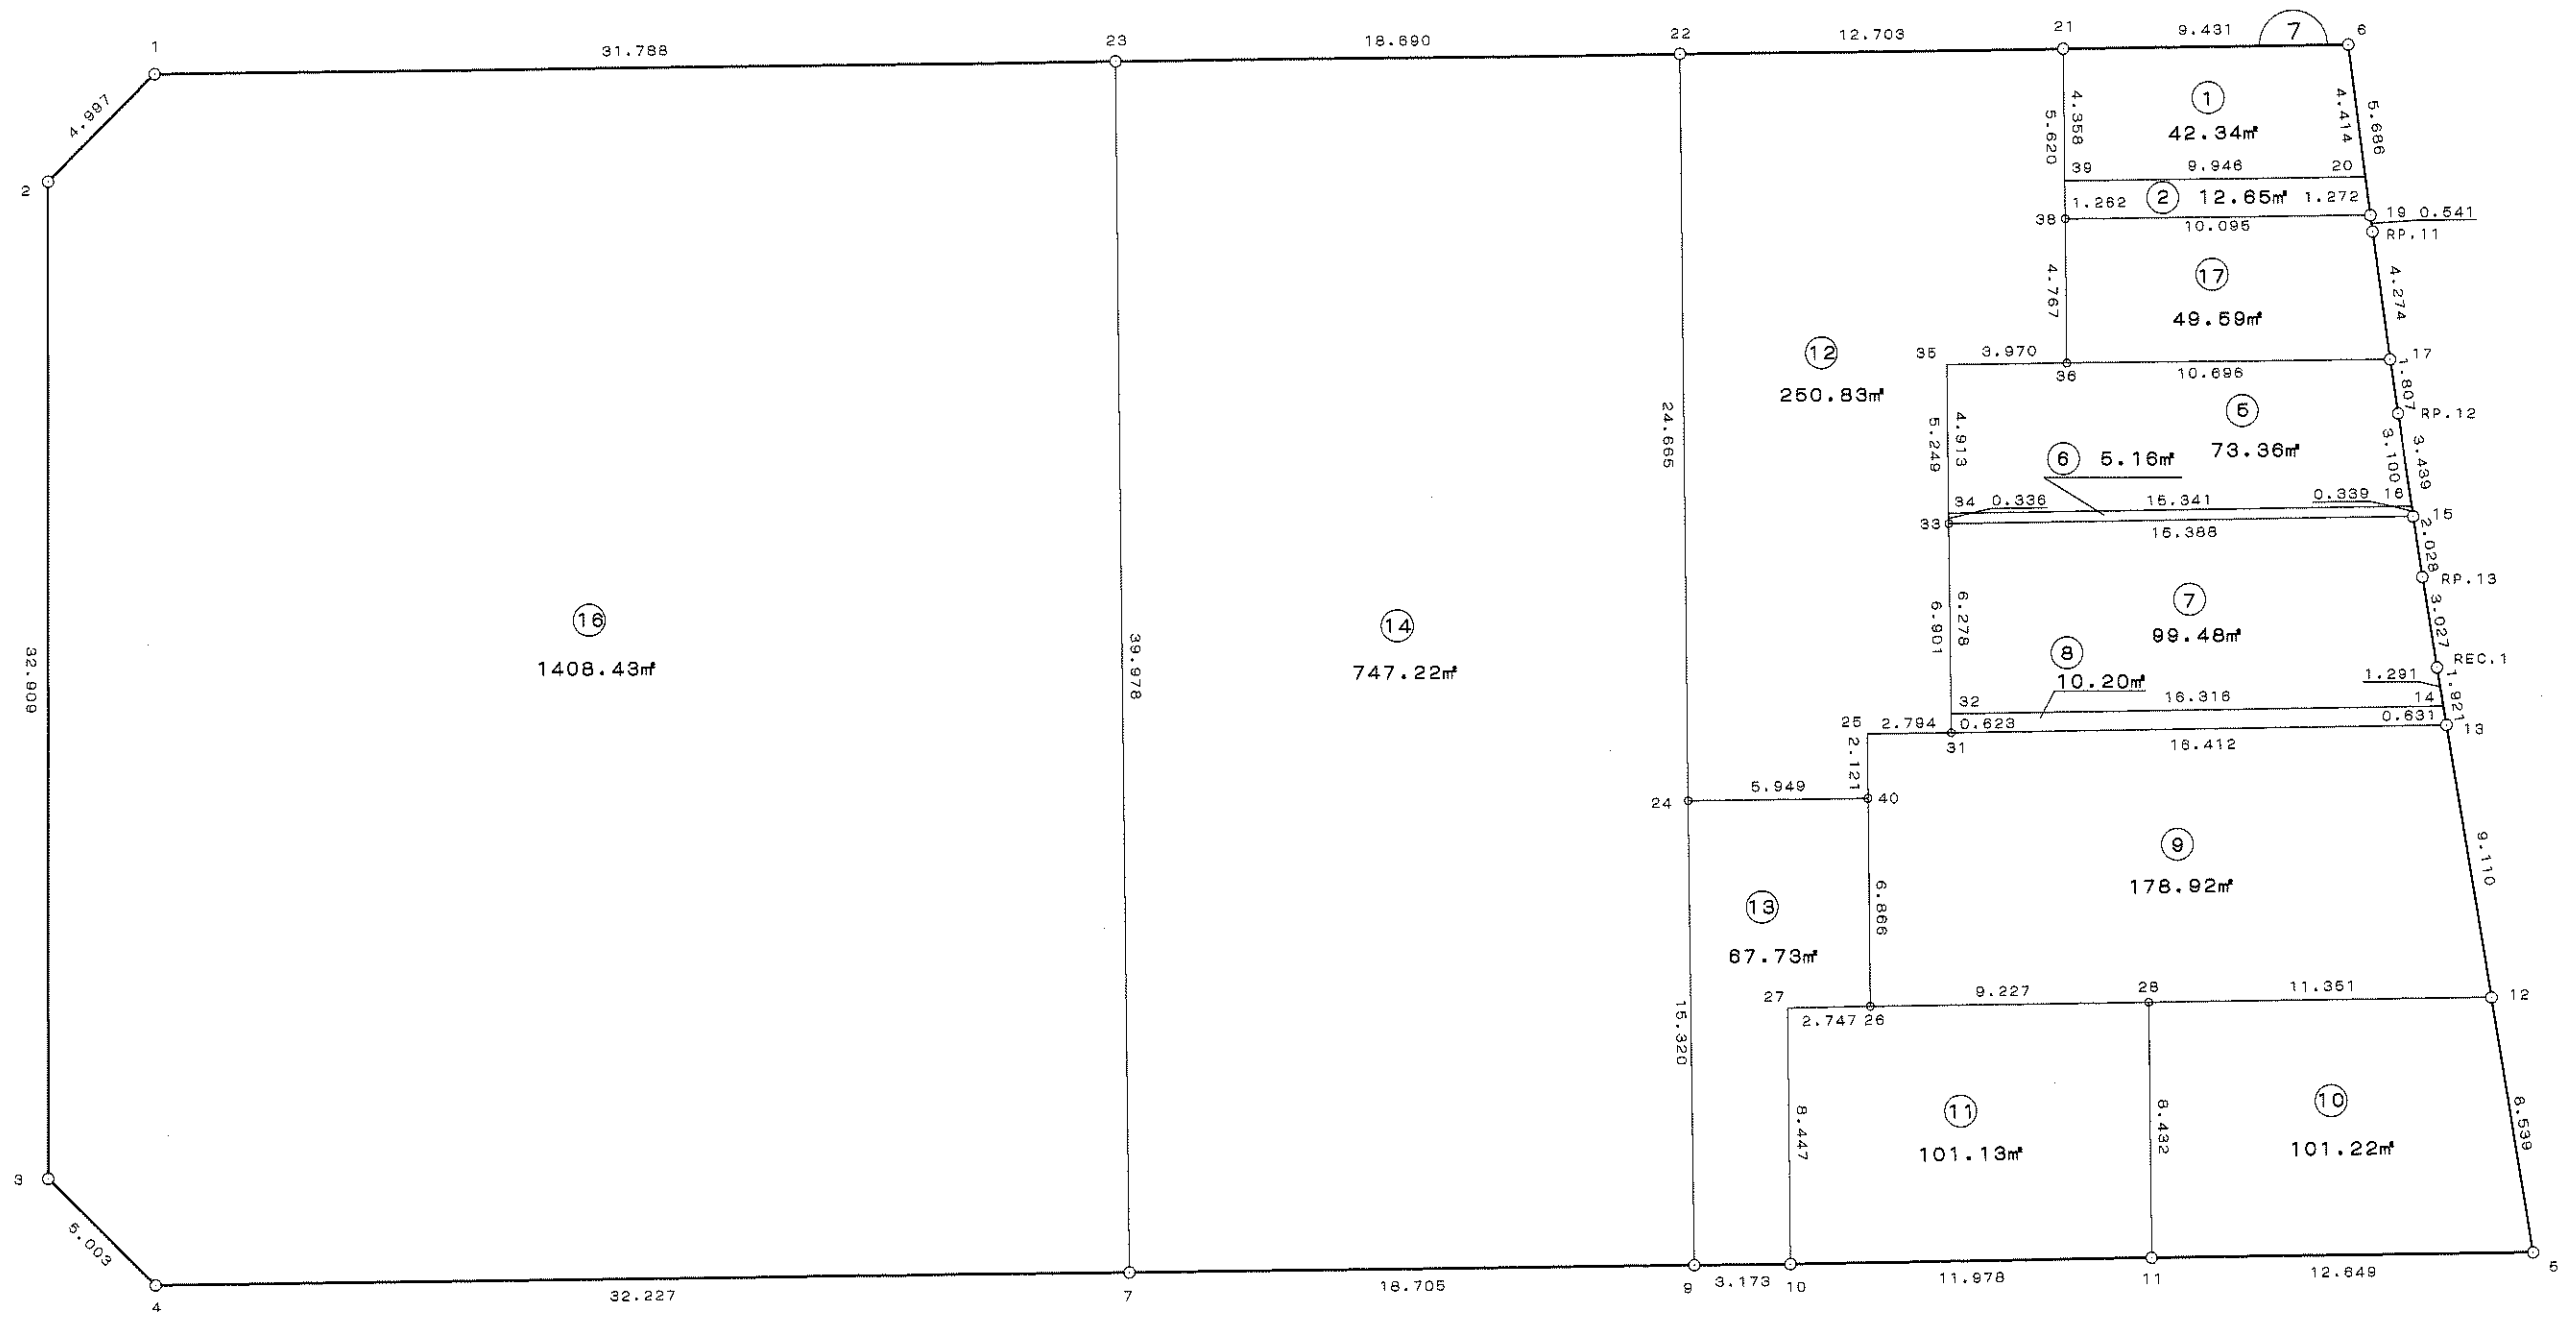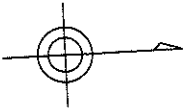

座標データリスト



現場名：佐野駅南地区 出来形

No	点 名	X	Y	No	点 名	X	Y
1	7B1	34645.3295562	-22656.4959179	26	7B28	34710.0832881	-22623.1803763
2	7B2	34641.6721342	-22653.0916623	27	7B31	34703.9007722	-22632.3395478
3	7B3	34640.3825638	-22620.2077800	28	7B 32	34703.9177785	-22632.9626367
4	7B4	34643.7919537	-22616.5461311	29	7B33	34704.0890587	-22639.2381266
5	7B5	34722.4939515	-22614.3960483	30	7B 34	34704.0983590	-22639.5738396
6	7B6	34717.9148186	-22654.5045299	31	7B35	34704.2344173	-22644.4851302
7	7B7	34676.0068398	-22615.6653150	32	7B36	34708.2029467	-22644.3765311
8	7B9	34694.7043070	-22615.1429620	33	7B38	34708.3387787	-22649.1416983
9	7B10	34697.8759859	-22615.0508727	34	7B 39	34708.3720867	-22650.4037062
10	7B11	34709.8499330	-22614.7519341	35	7B40	34701.0507727	-22630.2969550
11	7B12	34721.4299845	-22622.8682690	36	REC. 1	34720.0672911	-22633.8156572
12	7B13	34720.3071316	-22631.9092954	37	RP. 11	34718.4762922	-22648.3028468
13	7B 14	34720.2284246	-22632.5348944	38	RP. 12	34719.0868573	-22642.2531102
14	7B15	34719.4719019	-22638.8357278	39	RP. 13	34719.7032997	-22636.8208753
15	7B 16	34719.4339370	-22639.1726772				
16	7B17	34718.8939453	-22644.0494765				
17	7B19	34718.4288661	-22648.8419596				
18	7B 20	34718.3139013	-22650.1083722				
19	7B21	34708.4870583	-22654.7598797				
20	7B22	34695.7886669	-22655.1132170				
21	7B23	34677.1058822	-22655.6282205				
22	7B24	34695.1036225	-22630.4578036				
23	7B25	34701.1078428	-22632.4169831				
24	7B26	34700.8594798	-22623.4334220				
25	7B27	34698.1130681	-22623.4945449				

略 図 S = 1 / 250

街区面積 2,561.57 m²

画地面積 2,561.49 m²

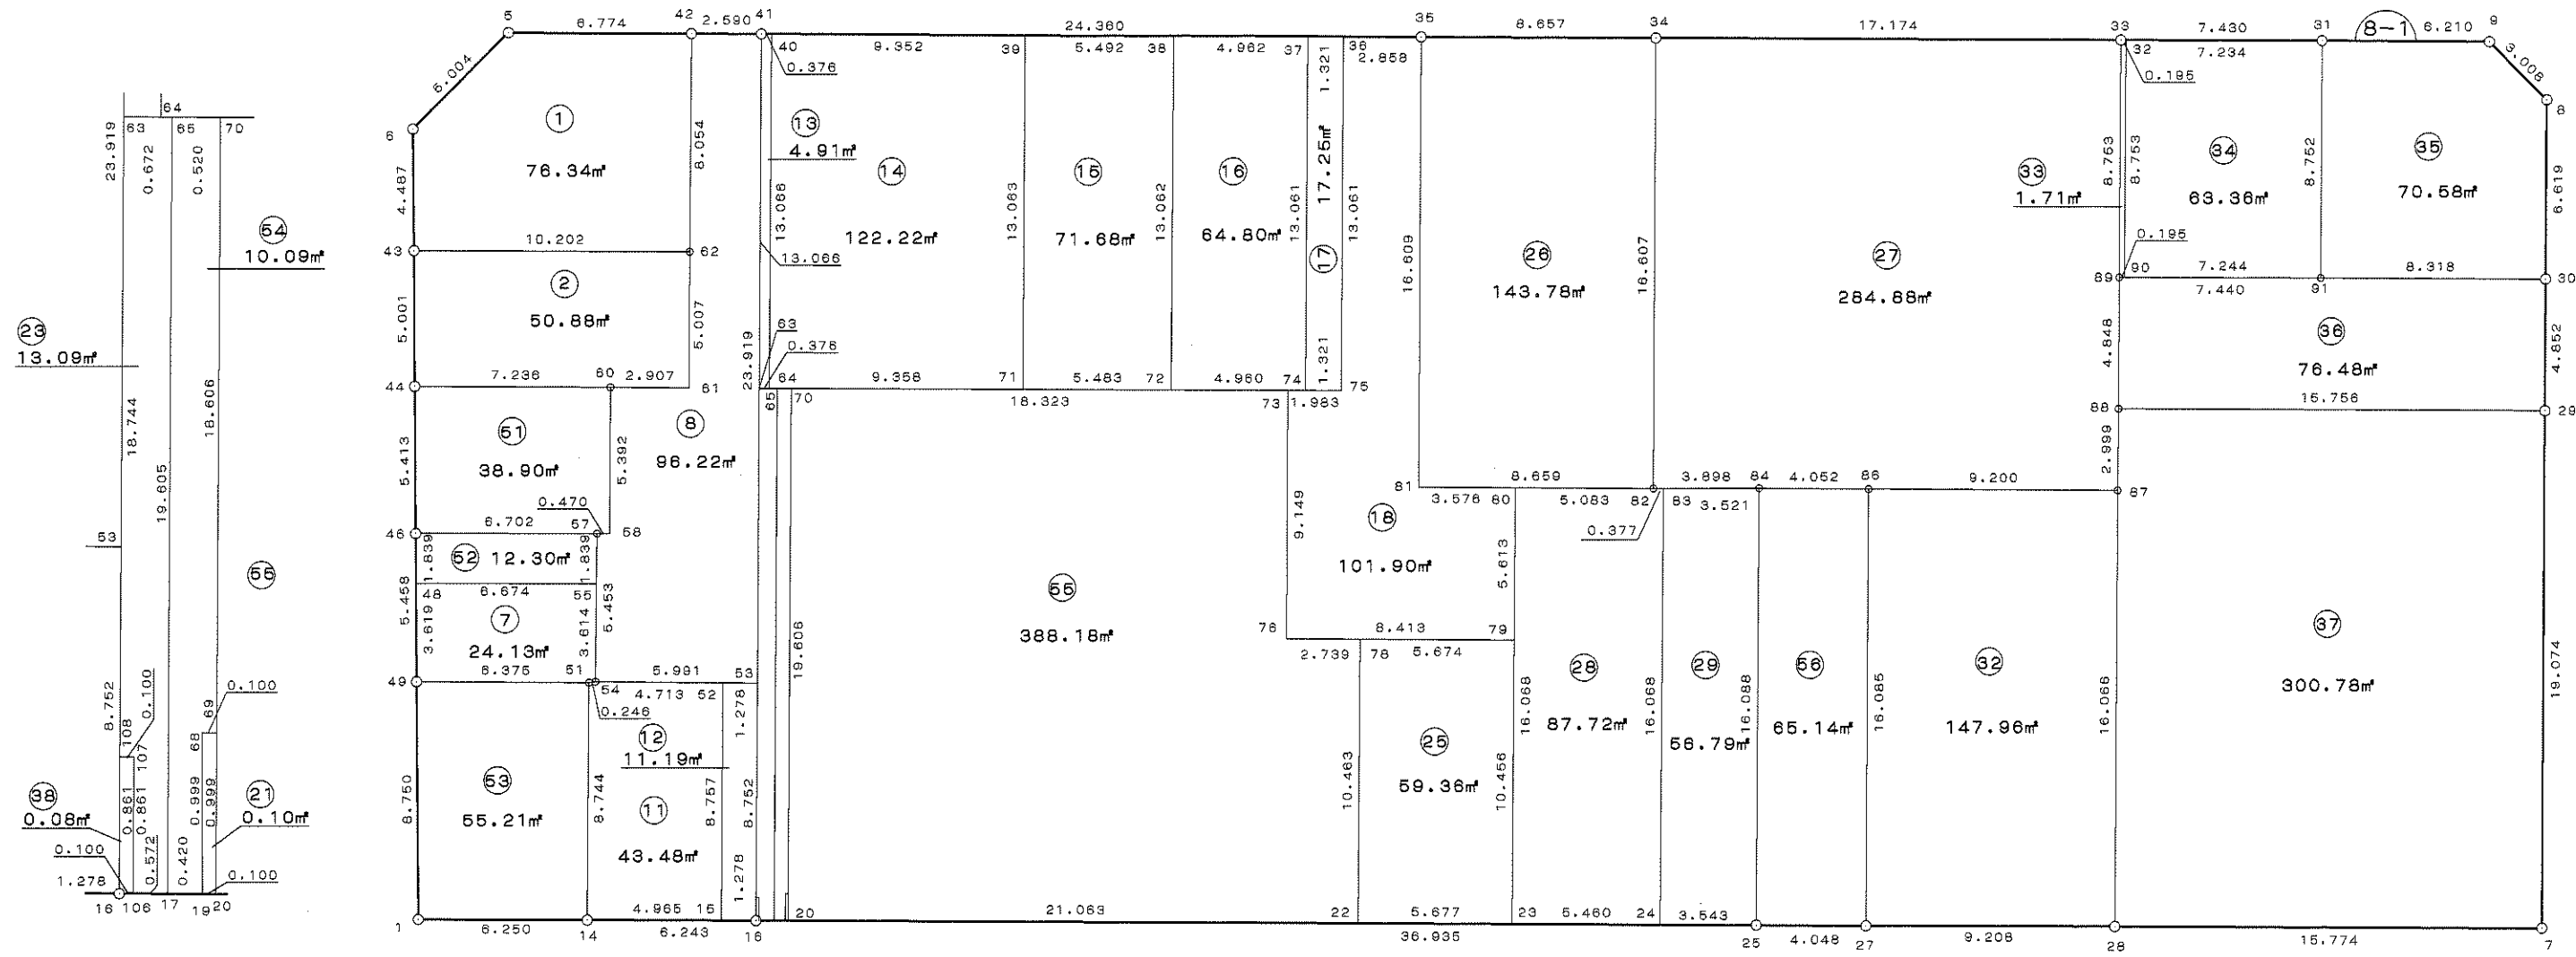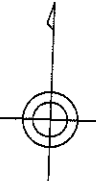

座標データリスト



現場名：佐野駅南地区 出来形

No	点 名	X	Y	No	点 名	X	Y	No	点 名	X	Y
1	8-1B1	34606.2166775	-22734.0827253	26	8-1B 36	34637.5269601	-22698.8124612	51	8-1B 68	34606.6825410	-22720.4684305
2	8-1B5	34638.7431164	-22729.6543603	27	8-1B 37	34637.5788700	-22700.1322007	52	8-1B 69	34606.6785693	-22720.3683442
3	8-1B6	34635.3144044	-22733.2984939	28	8-1B 38	34637.7738946	-22705.0904430	53	8-1B 70	34625.2701208	-22719.6275123
4	8-1B7	34603.0977878	-22655.6867819	29	8-1B 39	34637.9897437	-22710.5781195	54	8-1B 71	34624.9364617	-22711.0916518
5	8-1B8	34633.6196166	-22654.4825274	30	8-1B 40	34638.3572980	-22719.9226985	55	8-1B 72	34624.7223062	-22705.6130023
6	8-1B9	34635.8340504	-22656.5180582	31	8-1B41	34638.3720678	-22720.2982018	56	8-1B 73	34624.5544382	-22701.3185045
7	8-1B14	34605.9701394	-22727.8373681	32	8-1B42	34638.4755015	-22722.8860307	57	8-1B 74	34624.5285619	-22700.6565225
8	8-1B 15	34605.7770447	-22722.8762506	33	8-1B43	34630.8292691	-22733.4095167	58	8-1B 75	34624.4769740	-22699.3367701
9	8-1B16	34605.7273328	-22721.5990219	34	8-1B44	34625.8306971	-22733.5508707	59	8-1B 76	34615.4115968	-22701.6651231
10	8-1B 17	34605.7006844	-22720.9274787	35	8-1B46	34620.4192328	-22733.6963555	60	8-1B 78	34615.2992923	-22698.9279292
11	8-1B 19	34605.6840406	-22720.5080534	36	8-1B 48	34618.5806829	-22733.7482359	61	8-1B 79	34615.0667093	-22693.2591900
12	8-1B 20	34605.6800755	-22720.4081320	37	8-1B49	34614.9635901	-22733.8503035	62	8-1B 80	34620.6746579	-22693.0285171
13	8-1B 22	34604.8448884	-22699.3613171	38	8-1B51	34614.7068833	-22727.4805348	63	8-1B81	34620.8185890	-22696.6017114
14	8-1B 23	34604.6197938	-22693.6889051	39	8-1B 52	34614.5271539	-22722.5275782	64	8-1B82	34620.4700803	-22687.9497276
15	8-1B 24	34604.4033112	-22688.2335180	40	8-1B 53	34614.4724076	-22721.2505501	65	8-1B 83	34620.4573249	-22687.5731649
16	8-1B25	34604.2628164	-22684.6930331	41	8-1B54	34614.7290045	-22727.2360008	66	8-1B84	34620.3381188	-22684.0539731
17	8-1B27	34604.1004506	-22680.6487853	42	8-1B 55	34618.3395556	-22727.0787577	67	8-1B86	34620.1725688	-22680.0051692
18	8-1B28	34603.7429110	-22671.4477058	43	8-1B57	34620.1770879	-22726.9987313	68	8-1B87	34619.7962850	-22670.8124725
19	8-1B29	34622.1571921	-22654.9322684	44	8-1B58	34620.1568057	-22726.5291583	69	8-1B88	34622.7921814	-22670.6751512
20	8-1B30	34627.0057454	-22654.7445794	45	8-1B60	34625.5450700	-22726.3205102	70	8-1B89	34627.6362049	-22670.4897470
21	8-1B31	34636.0926858	-22662.7229499	46	8-1B61	34625.4260880	-22723.4154864	71	8-1B 90	34627.6286043	-22670.2944883
22	8-1B 32	34636.3747465	-22669.9518810	47	8-1B62	34630.4286860	-22723.2150716	72	8-1B91	34627.3468200	-22663.0555108
23	8-1B33	34636.3823651	-22670.1471389	48	8-1B 63	34625.3166727	-22720.8184303	73	8-1B 106	34605.7233677	-22721.4991005
24	8-1B34	34637.0650589	-22687.3072379	49	8-1B 64	34625.3019944	-22720.4429233	74	8-1B 107	34606.5834133	-22721.4649719
25	8-1B35	34637.4146424	-22695.9569329	50	8-1B 65	34625.2904220	-22720.1468713	75	8-1B 108	34606.5873728	-22721.5647512

略 ☒ S = 1 / 2 5 0

街区面積 1,096.11 m²

画地面積 1,096.07 m²

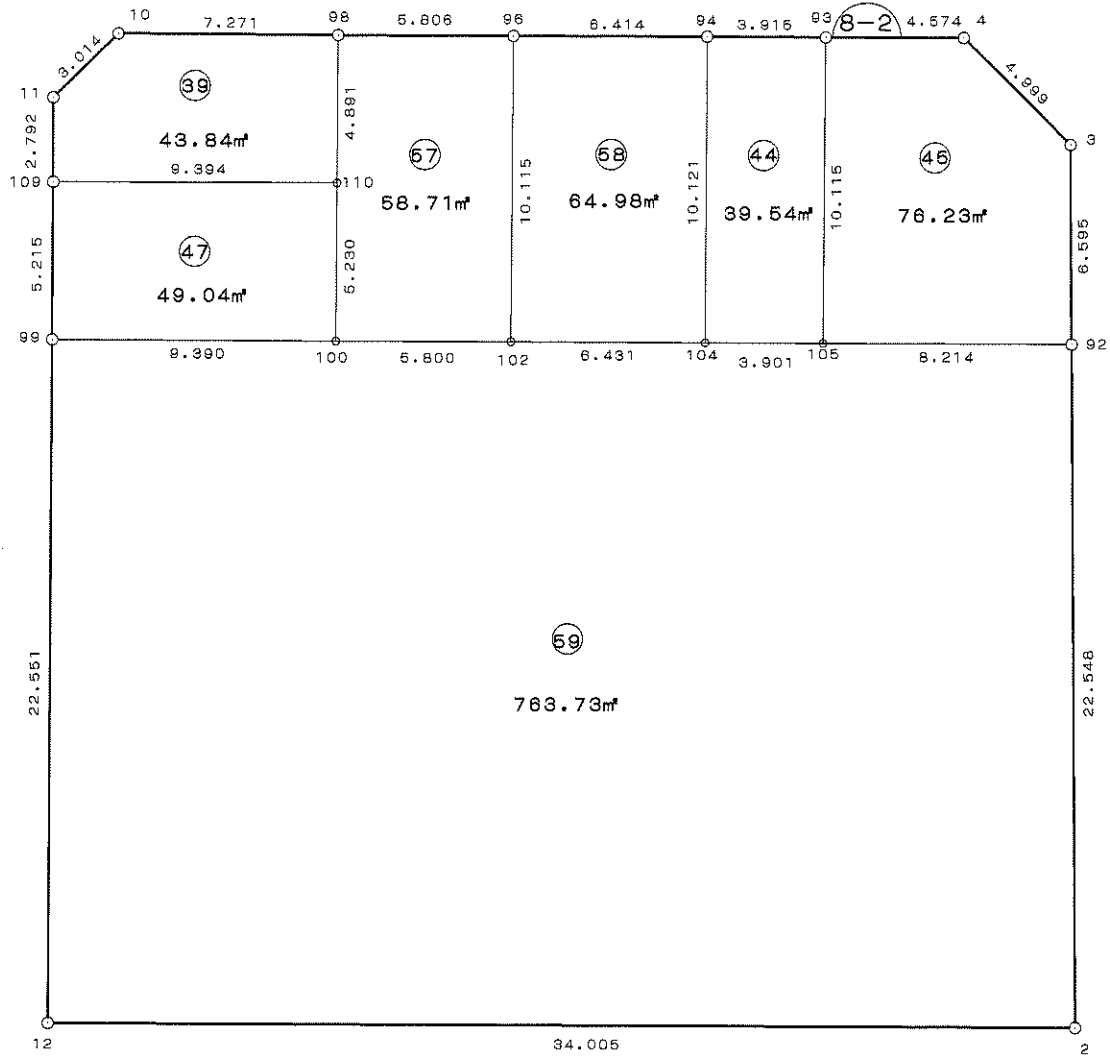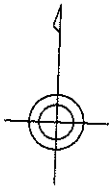

座標データリスト



現場名：佐野駅南地区 出来形

No	点 名	X	Y
1	8-2B2	34601.5938227	-22617.7188043
2	8-2B3	34630.7260442	-22616.9112324
3	8-2B4	34634.3819535	-22620.3210562
4	8-2B10	34635.5044491	-22648.2784548
5	8-2B11	34633.4693034	-22650.5012032
6	8-2B12	34602.9351788	-22651.6969655
7	8-2B92	34624.1336446	-22617.0933421
8	8-2B93	34634.5649361	-22624.8911325
9	8-2B94	34634.7230054	-22628.8032901
10	8-2B96	34634.9754550	-22635.2121964
11	8-2B98	34635.2096709	-22641.0139173
12	8-2B99	34625.4680156	-22650.8035998
13	8-2B100	34625.0970374	-22641.4207098
14	8-2B102	34624.8687190	-22635.6252055
15	8-2B104	34624.6100885	-22629.1990806
16	8-2B105	34624.4582465	-22625.3010718
17	8-2B109	34630.6786478	-22650.5980102
18	8-2B110	34630.3229570	-22641.2105886

略 ☒ S = 1 / 250

街区面積 1,717.08 m²

画地面積 1,716.98 m²

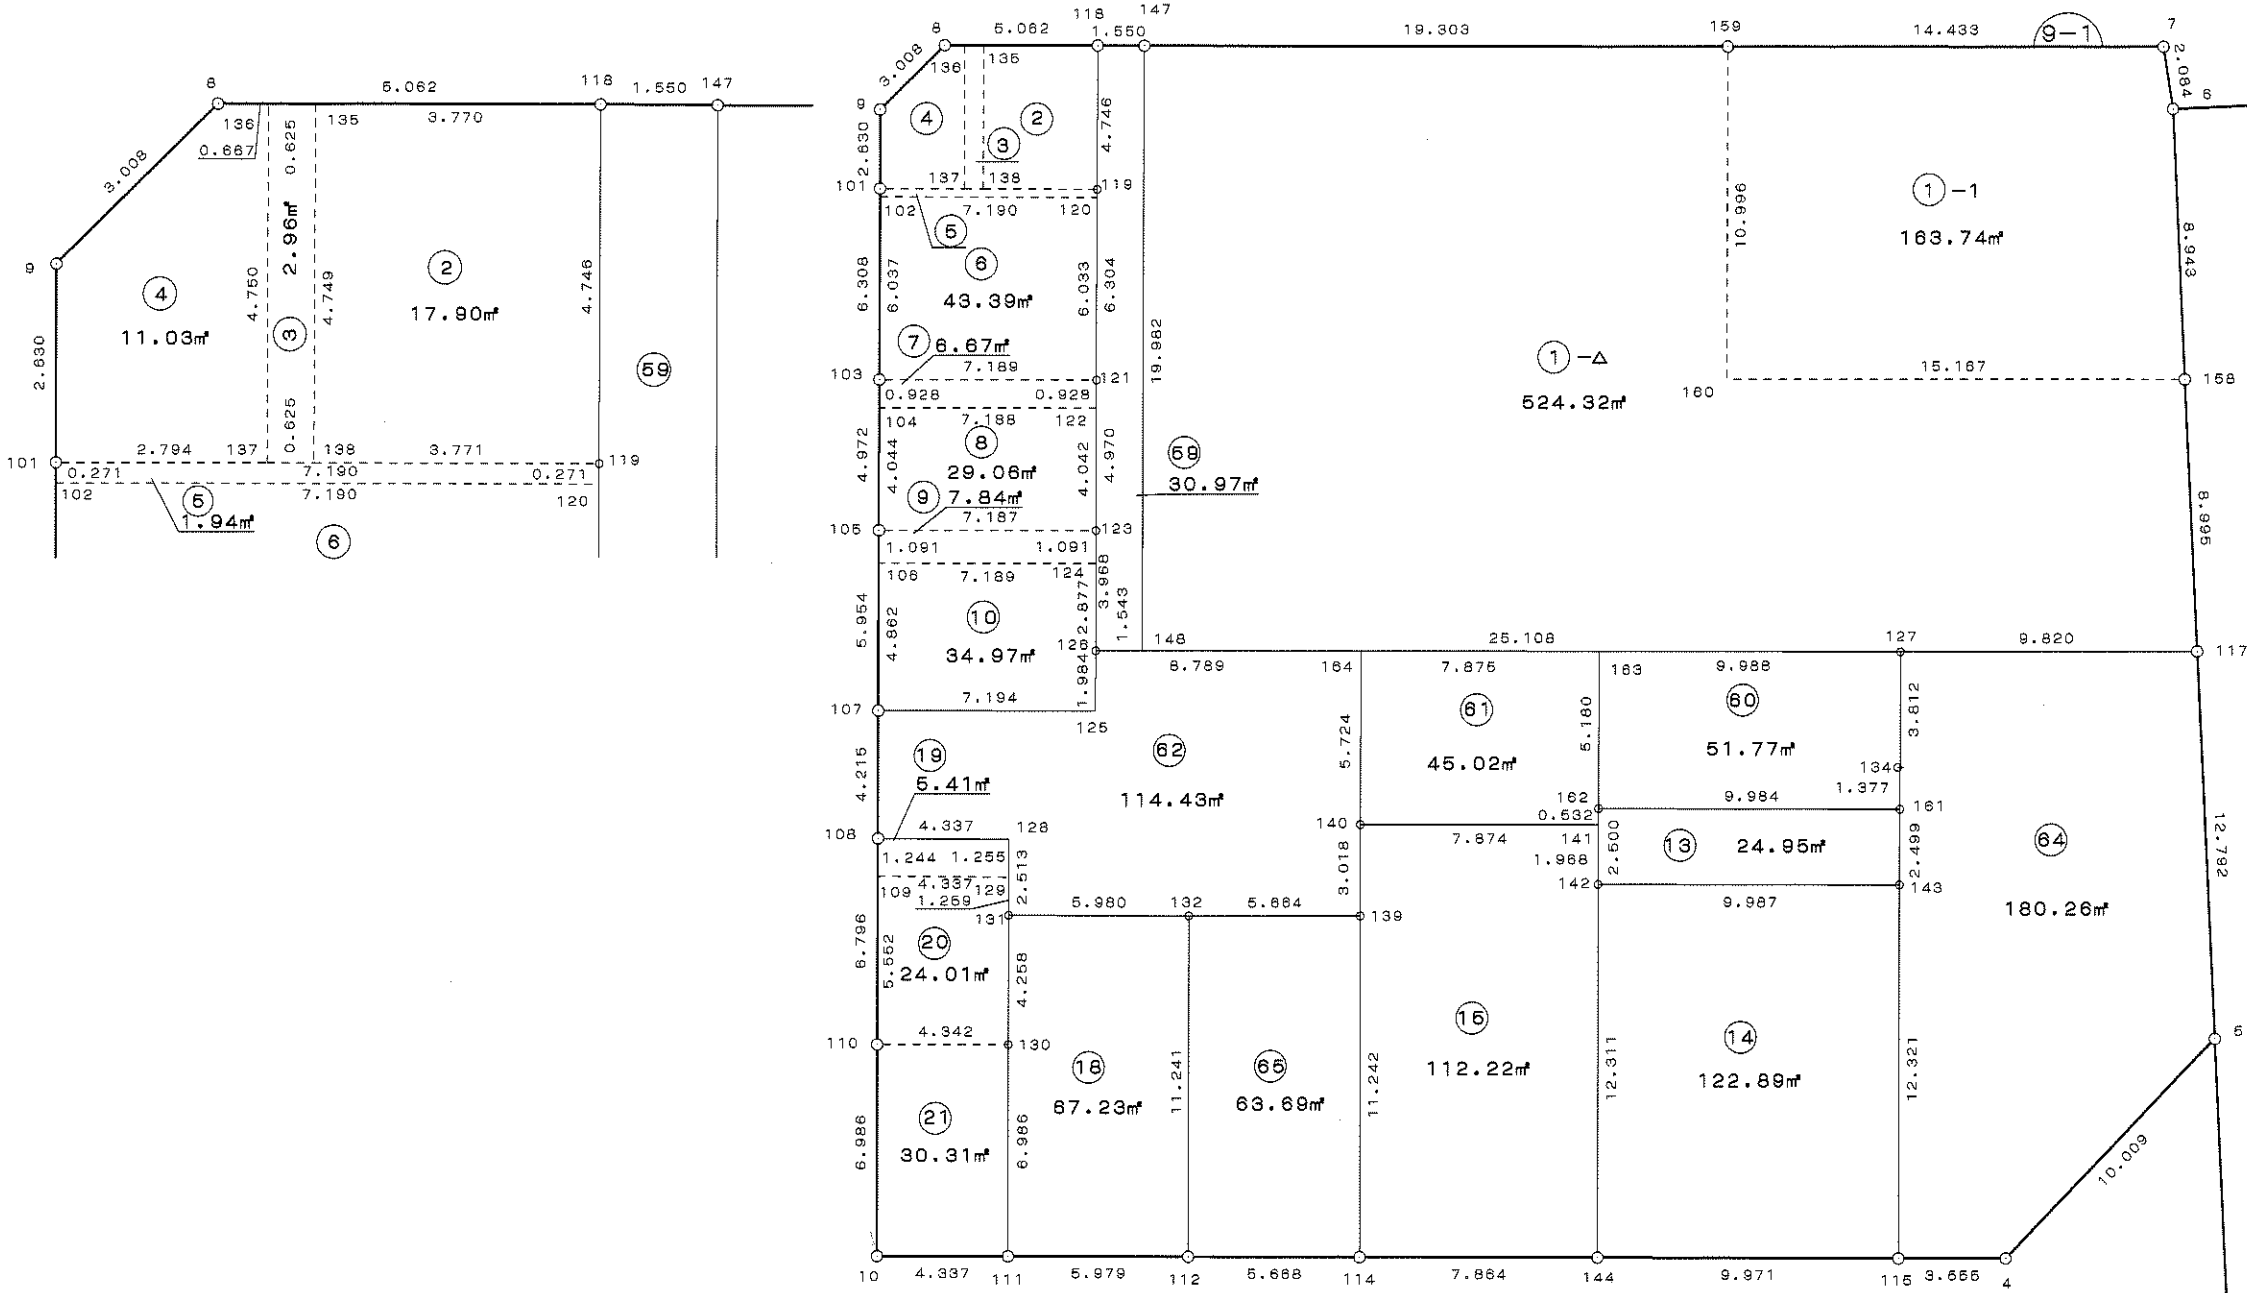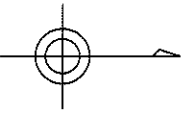

座標データリスト



現場名：佐野駅南地区 出来形

No	点 名	X	Y	No	点 名	X	Y	No	点 名	X	Y
1	9-1B4	34717.0692318	-22568.5129189	26	9-1B121	34687.6791676	-22598.2763949	51	9-1B158	34723.7045341	-22597.3537883
2	9-1B5	34724.1664053	-22575.5710806	27	9-1B 122	34687.6539945	-22597.3488647	52	9-1B159	34708.8327230	-22608.7467842
3	9-1B6	34723.5306674	-22606.2954374	28	9-1B123	34687.5443261	-22593.3080189	53	9-1B160	34708.5426885	-22597.7542280
4	9-1B7	34723.2610191	-22608.3618415	29	9-1B 124	34687.5153727	-22592.2170879	54	9-1B161	34713.9272071	-22583.4230031
5	9-1B8	34682.9284147	-22609.4669803	30	9-1B125	34687.3804791	-22587.3579591	55	9-1B 162	34703.9475497	-22583.7058455
6	9-1B9	34680.7363652	-22607.4069466	31	9-1B126	34687.4390451	-22589.3411463	56	9-1B 163	34704.0962972	-22588.8839259
7	9-1B10	34679.7108746	-22569.5609263	32	9-1B127	34714.0805367	-22588.6098713	57	9-1B 164	34696.2242621	-22589.1000033
8	9-1B101	34680.6660297	-22604.7779538	33	9-1B128	34684.4129960	-22583.1966037				
9	9-1B 102	34680.6585951	-22604.5069638	34	9-1B 129	34684.3780774	-22581.9424969				
10	9-1B103	34680.4930215	-22598.4718682	35	9-1B130	34684.2274969	-22576.4283467				
11	9-1B 104	34680.4682203	-22597.5443279	36	9-1B131	34684.3430485	-22580.6844298				
12	9-1B105	34680.3601327	-22593.5019497	37	9-1B132	34690.3202249	-22580.5164927				
13	9-1B 106	34680.3288541	-22592.4110815	38	9-1B 134	34713.9684439	-22584.7998757				
14	9-1B107	34680.1894942	-22587.5507785	39	9-1B 135	34684.2199319	-22609.4299481				
15	9-1B108	34680.0787722	-22583.3371485	40	9-1B 136	34683.5954024	-22609.4478555				
16	9-1B 109	34680.0436818	-22582.0940263	41	9-1B 137	34683.4592722	-22604.7002424				
17	9-1B110	34679.8870250	-22576.5442541	42	9-1B 138	34684.0838170	-22604.6828668				
18	9-1B111	34684.0463523	-22569.4447643	43	9-1B139	34695.9816592	-22580.3612338				
19	9-1B112	34690.0227225	-22569.2793829	44	9-1B140	34696.0596995	-22583.3784311				
20	9-1B114	34695.6886971	-22569.1227499	45	9-1B141	34703.9312581	-22583.1742795				
21	9-1B115	34713.5154881	-22568.6092450	46	9-1B142	34703.8709649	-22581.2070115				
22	9-1B117	34723.8974645	-22588.3605371	47	9-1B143	34713.8544510	-22580.9252959				
23	9-1B118	34687.9880678	-22609.3219028	48	9-1B144	34703.5491620	-22568.9006719				
24	9-1B119	34687.8537265	-22604.5779833	49	9-1B147	34689.5372736	-22609.2729371				
25	9-1B 120	34687.8462199	-22604.3069952	50	9-1B 148	34688.9816089	-22589.2988049				

S = 1 / 250

街区面積 3,001.43 m²


画地面積 3,001.36 m²

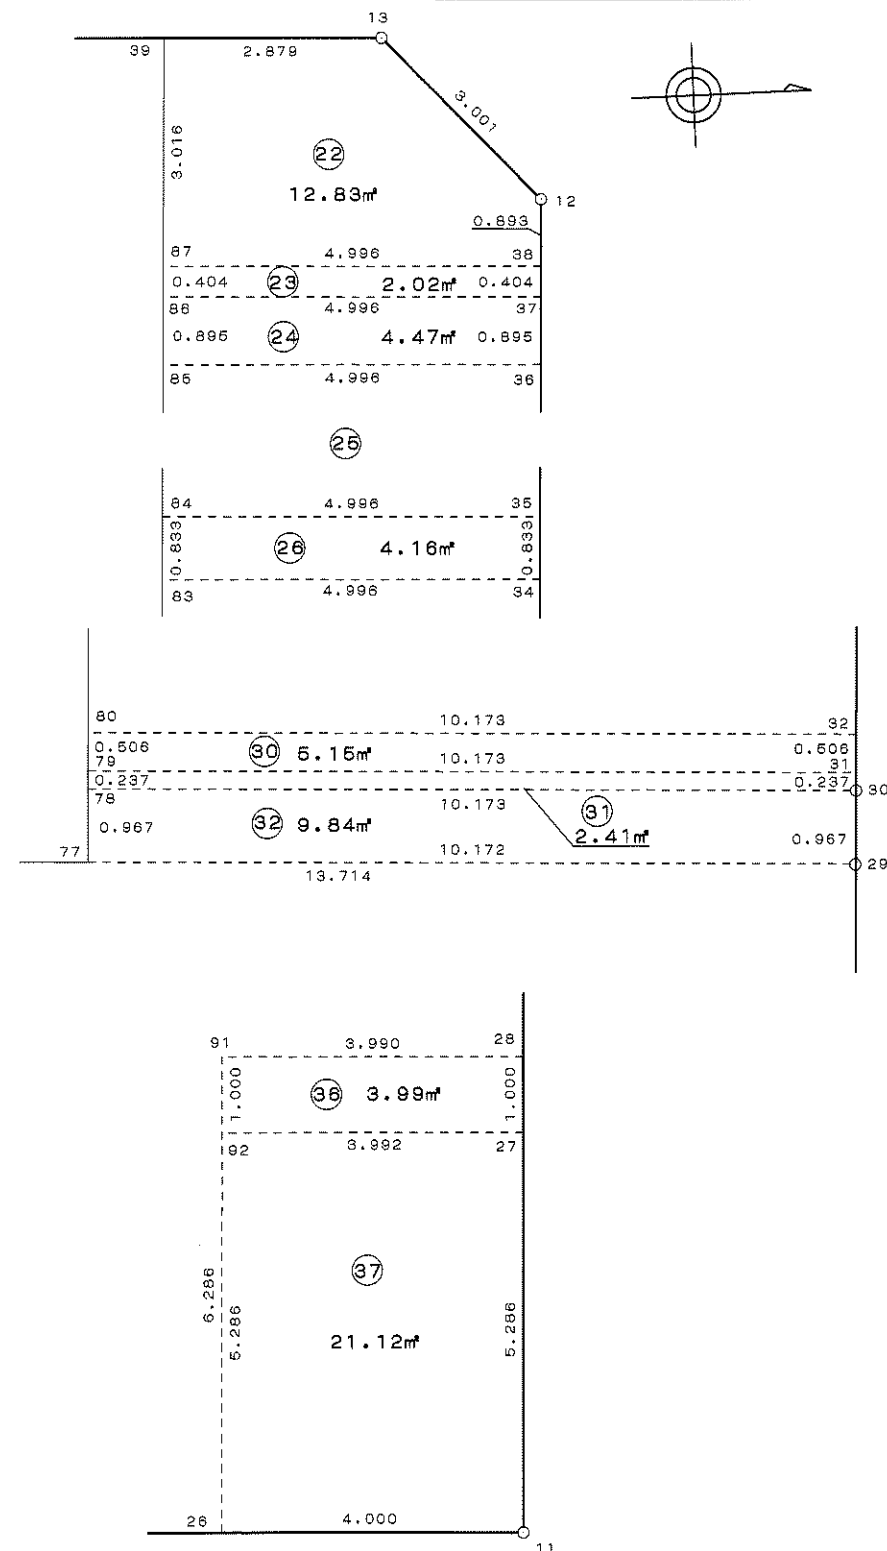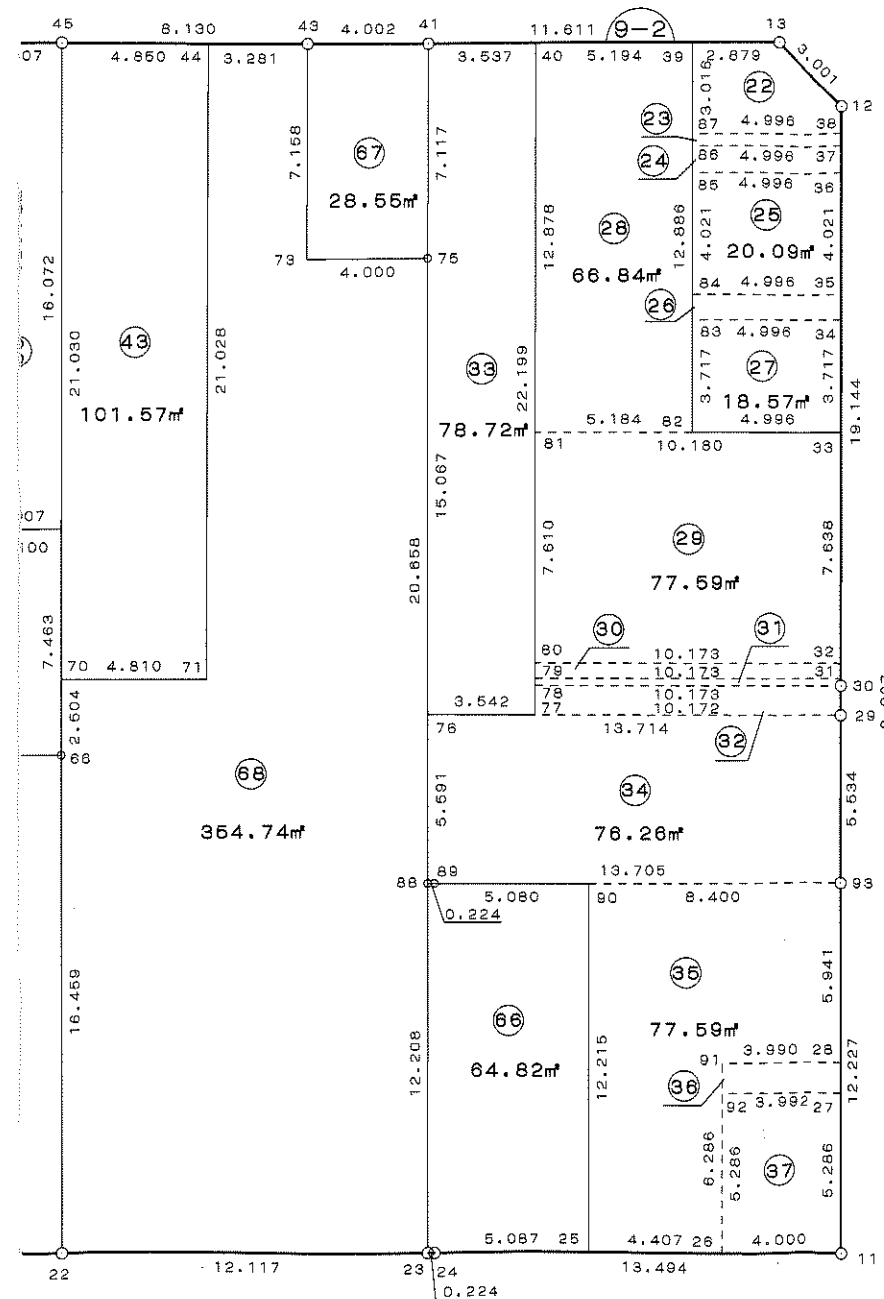

9-2B

(2)

略

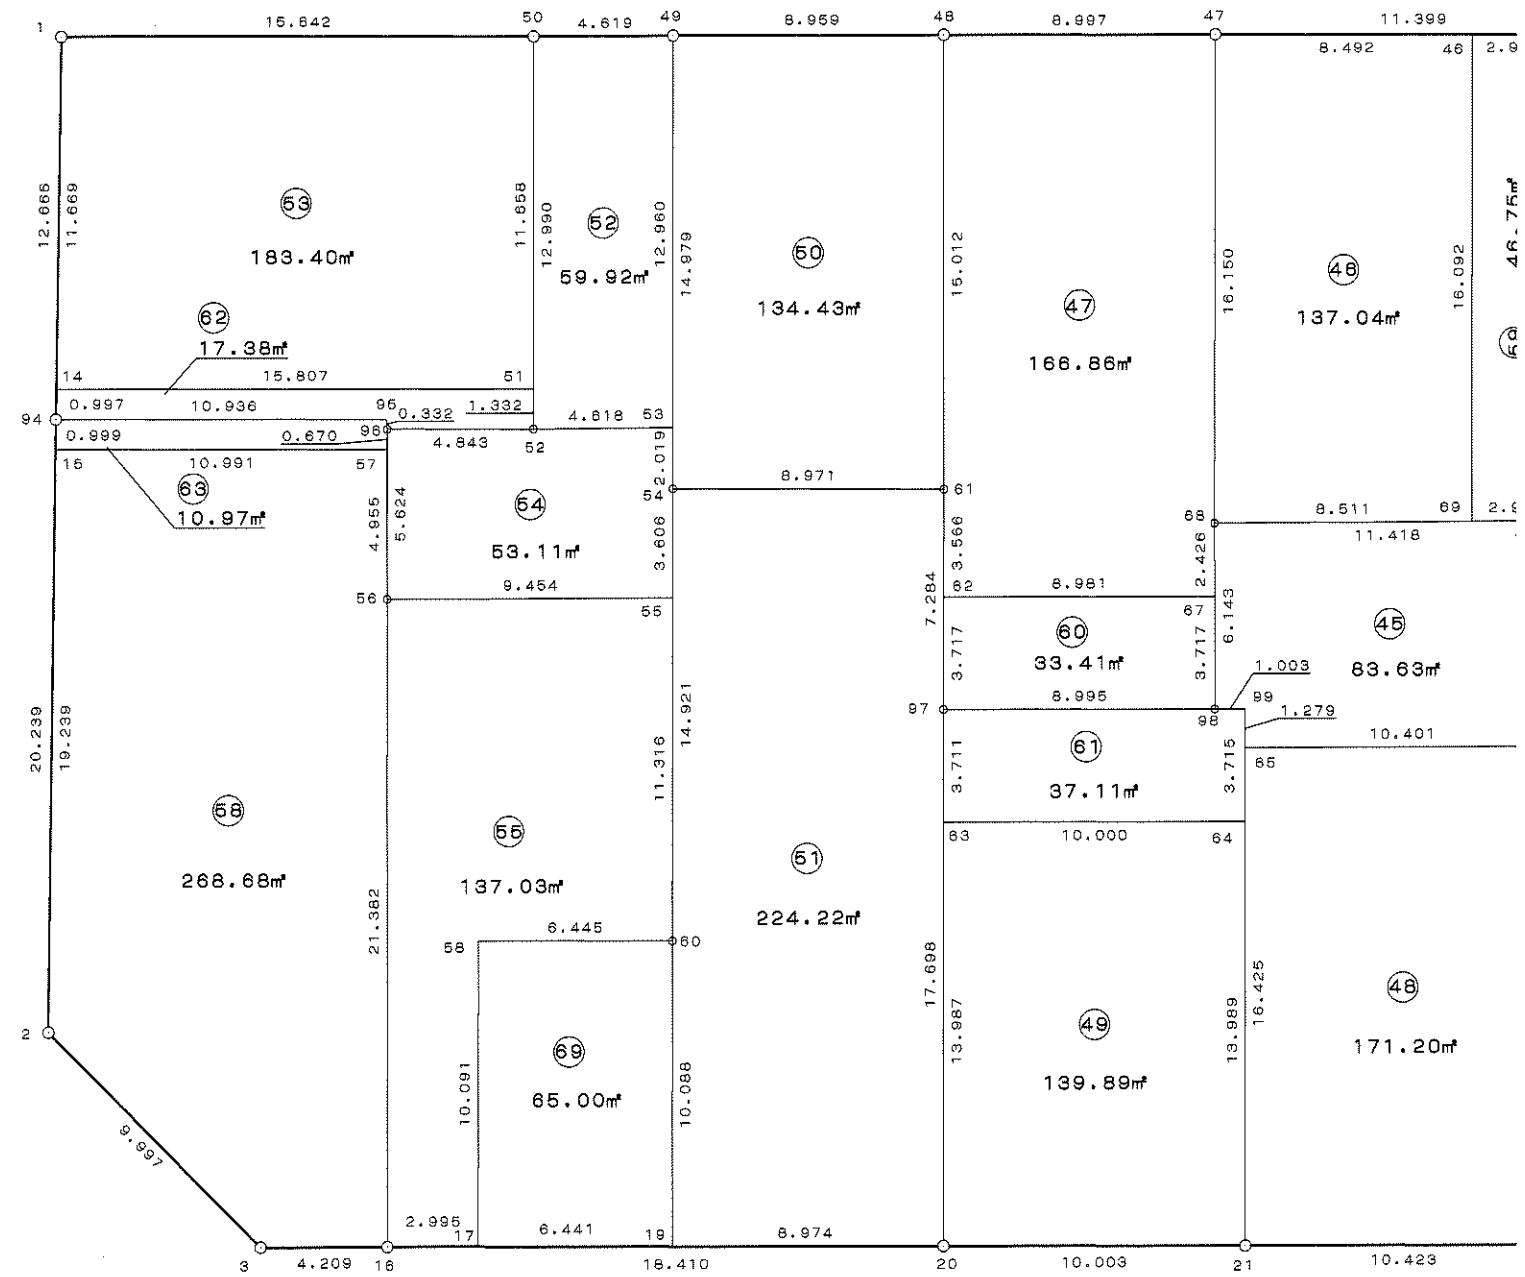

座標データリスト

PAGE: 1

現場名：佐野駅南地区 出来形

No	点 名	X	Y	No	点 名	X	Y
1	9-2B1	34601.3553198	-22611.7143316	26	9-2B 34	34676.5477461	-22600.4741832
2	9-2B2	34600.0255264	-22578.8361143	27	9-2B 35	34676.5709061	-22601.3065275
3	9-2B3	34606.8549743	-22571.5355302	28	9-2B 36	34676.6827531	-22605.3261833
4	9-2B11	34675.7105656	-22569.6592256	29	9-2B 37	34676.7076389	-22606.2205531
5	9-2B12	34676.7437126	-22607.5169998	30	9-2B 38	34676.7188849	-22606.6247212
6	9-2B13	34674.6869146	-22609.7023990	31	9-2B 39	34671.8086871	-22609.7781669
7	9-2B 14	34600.8716252	-22600.0550084	32	9-2B 40	34666.6164897	-22609.9148489
8	9-2B 15	34600.7905641	-22598.0603666	33	9-2B41	34663.0802364	-22610.0079390
9	9-2B16	34611.0626068	-22571.4319733	34	9-2B43	34659.0799578	-22610.1201869
10	9-2B 17	34614.0564989	-22571.3505191	35	9-2B 44	34655.8005689	-22610.2108850
11	9-2B 19	34620.4951164	-22571.1753449	36	9-2B45	34650.9527251	-22610.3449619
12	9-2B20	34629.4660633	-22570.9312741	37	9-2B 46	34648.0468001	-22610.4244712
13	9-2B21	34639.4654846	-22570.6510825	38	9-2B47	34639.5584745	-22610.6567214
14	9-2B22	34649.8847896	-22570.3654332	39	9-2B48	34630.5646675	-22610.9098342
15	9-2B23	34661.9971545	-22570.0401101	40	9-2B49	34621.6086165	-22611.1478020
16	9-2B 24	34662.2215138	-22570.0338482	41	9-2B50	34616.9913339	-22611.2751117
17	9-2B 25	34667.3064850	-22569.8926315	42	9-2B 51	34616.6727241	-22599.6212136
18	9-2B 26	34671.7121076	-22569.7702812	43	9-2B52	34616.6363252	-22598.2898384
19	9-2B 27	34675.8488353	-22574.9430411	44	9-2B 53	34621.2530233	-22598.1930978
20	9-2B 28	34675.8749973	-22575.9427891	45	9-2B54	34621.1976236	-22596.1748159
21	9-2B 29	34676.1850957	-22587.4133684	46	9-2B 55	34621.0959857	-22592.5707099
22	9-2B 30	34676.2112349	-22588.3803401	47	9-2B56	34611.6451991	-22592.8056129
23	9-2B 31	34676.2178242	-22588.6171531	48	9-2B 57	34611.7772968	-22597.7587427
24	9-2B 32	34676.2319047	-22589.1231898	49	9-2B 58	34614.3344528	-22581.4372388
25	9-2B 33	34676.4443615	-22596.7586525	50	9-2B 60	34620.7770087	-22581.2597050


座標データリスト

PAGE: 2

No	点 名	X	Y
51	9-2B61	34630.1645854	-22595.9029958
52	9-2B 62	34630.0620745	-22592.3380101
53	9-2B 63	34629.8526578	-22584.9127201
54	9-2B 64	34639.8482972	-22584.6347751
55	9-2B65	34639.9149612	-22587.0699313
56	9-2B66	34650.3133749	-22586.8192796
57	9-2B 67	34639.0397239	-22592.0883719
58	9-2B68	34639.1000669	-22594.5131270
59	9-2B 69	34647.6096403	-22594.3386320
60	9-2B 70	34650.3813983	-22589.3222844
61	9-2B 71	34655.1900944	-22589.1915999
62	9-2B73	34658.8721467	-22602.9650306
63	9-2B75	34662.8713594	-22602.8942519
64	9-2B 76	34662.4766518	-22587.8325080
65	9-2B 77	34666.0170162	-22587.7242604
66	9-2B 78	34666.0431387	-22588.6912325
67	9-2B 79	34666.0495363	-22588.9280514
68	9-2B 80	34666.0632071	-22589.4341007
69	9-2B 81	34666.2687271	-22597.0417896
70	9-2B 82	34671.4502856	-22596.8976127
71	9-2B 83	34671.5536703	-22600.6131434
72	9-2B 84	34671.5768303	-22601.4454877
73	9-2B 85	34671.6886772	-22605.4651435
74	9-2B 86	34671.7135631	-22606.3595133
75	9-2B 87	34671.7248091	-22606.7636814

No	点 名	X	Y
76	9-2B88	34662.3301803	-22582.2432703
77	9-2B 89	34662.5545573	-22582.2376563
78	9-2B 90	34667.6331039	-22582.1034531
79	9-2B 91	34671.8866095	-22576.0535650
80	9-2B 92	34671.8588453	-22575.0538615
81	9-2B93	34676.0304060	-22581.8815501
82	9-2B94	34600.8303044	-22599.0589799
83	9-2B95	34611.7621855	-22598.7588619
84	9-2B96	34611.7951473	-22598.4280673
85	9-2B97	34629.9552349	-22588.6224861
86	9-2B98	34638.9472487	-22588.3724485
87	9-2B99	34639.9499616	-22588.3484523
88	9-2B 100	34650.5161063	-22594.2790328

画地面積 2,034.40 m²

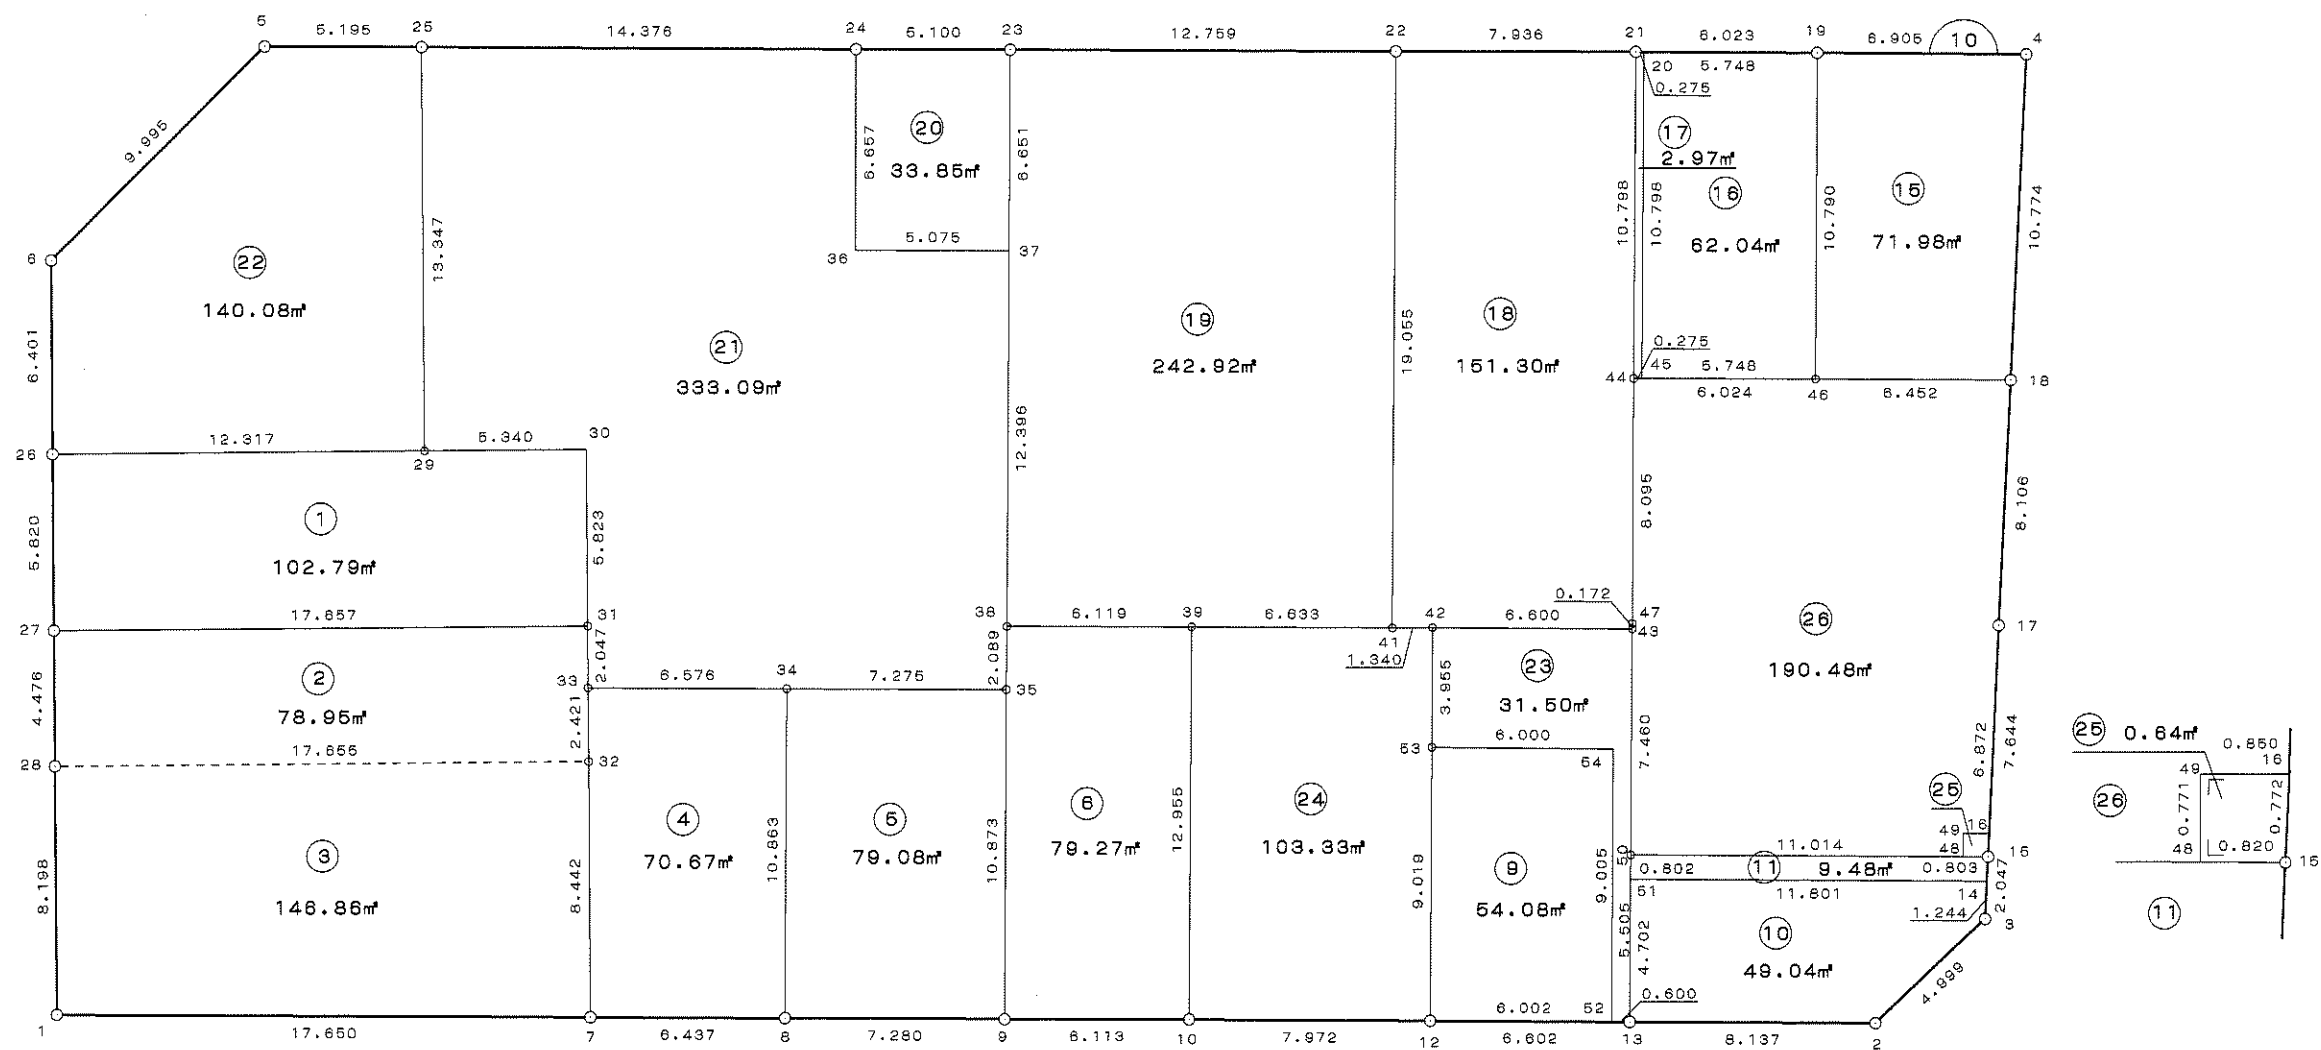

座標データリスト


現場名：佐野駅南地区 出来形

No	点 名	X	Y	No	点 名	X	Y	No	点 名	X	Y
1	10B1	34564.0251360	-22780.1954505	26	10B27	34576.6940618	-22779.8638944	51	10B53	34571.2231646	-22734.4164640
2	10B2	34561.6127897	-22720.0524315	27	10B28	34572.2199792	-22779.9808450	52	10B54	34570.9680460	-22728.4214441
3	10B3	34564.9240778	-22716.3076315	28	10B29	34582.1876915	-22767.3970617				
4	10B4	34593.4005718	-22713.9950261	29	10B30	34582.0460018	-22762.0589417				
5	10B5	34595.7381223	-22772.2423262	30	10B31	34576.2252170	-22762.2130853				
6	10B6	34588.9107724	-22779.5417871	31	10B32	34571.7585462	-22762.3320122				
7	10B7	34563.3192361	-22762.5596266	32	10B33	34574.1787593	-22762.2676946				
8	10B8	34563.0677778	-22756.1273699	33	10B34	34573.9217677	-22755.6966565				
9	10B9	34562.7704616	-22748.8538740	34	10B35	34573.6348031	-22748.4275021				
10	10B10	34562.5382196	-22742.7452776	35	10B 36	34588.3047938	-22752.9195723				
11	10B12	34562.2114760	-22734.7795486	36	10B37	34588.1081241	-22747.8481889				
12	10B13	34561.9462570	-22728.1830248	37	10B38	34575.7222908	-22748.3410292				
13	10B 14	34566.1643556	-22716.2059003	38	10B39	34575.4828560	-22742.2271902				
14	10B15	34566.9645587	-22716.1402653	39	10B41	34575.2159638	-22735.5999735				
15	10B 16	34567.7341942	-22716.0789403	40	10B42	34575.1751098	-22734.2610156				
16	10B17	34574.5840230	-22715.5331423	41	10B43	34574.9002447	-22727.6663381				
17	10B18	34582.6622340	-22714.8682316	42	10B44	34583.1605702	-22727.3341458				
18	10B19	34593.6999003	-22720.8937198	43	10B 45	34583.1495155	-22727.0592742				
19	10B 20	34593.9388436	-22726.6362509	44	10B46	34582.9185135	-22721.3154615				
20	10B21	34593.9502802	-22726.9111076	45	10B47	34575.0720554	-22727.6581517				
21	10B22	34594.2558604	-22734.8414468	46	10B 48	34566.9979552	-22716.9595849				
22	10B23	34594.7541285	-22747.5904550	47	10B 49	34567.7688096	-22716.9281639				
23	10B24	34594.9574608	-22752.6864459	48	10B50	34567.4465454	-22727.9648836				
24	10B25	34595.5303153	-22767.0514156	49	10B 51	34566.6449627	-22727.9966743				
25	10B26	34582.5115456	-22779.7098033	50	10B 52	34561.9703610	-22728.7825404				

略 ☒ S = 1 / 250

街区面積 2,585.09 m²

画地面積 2,584.99 m²

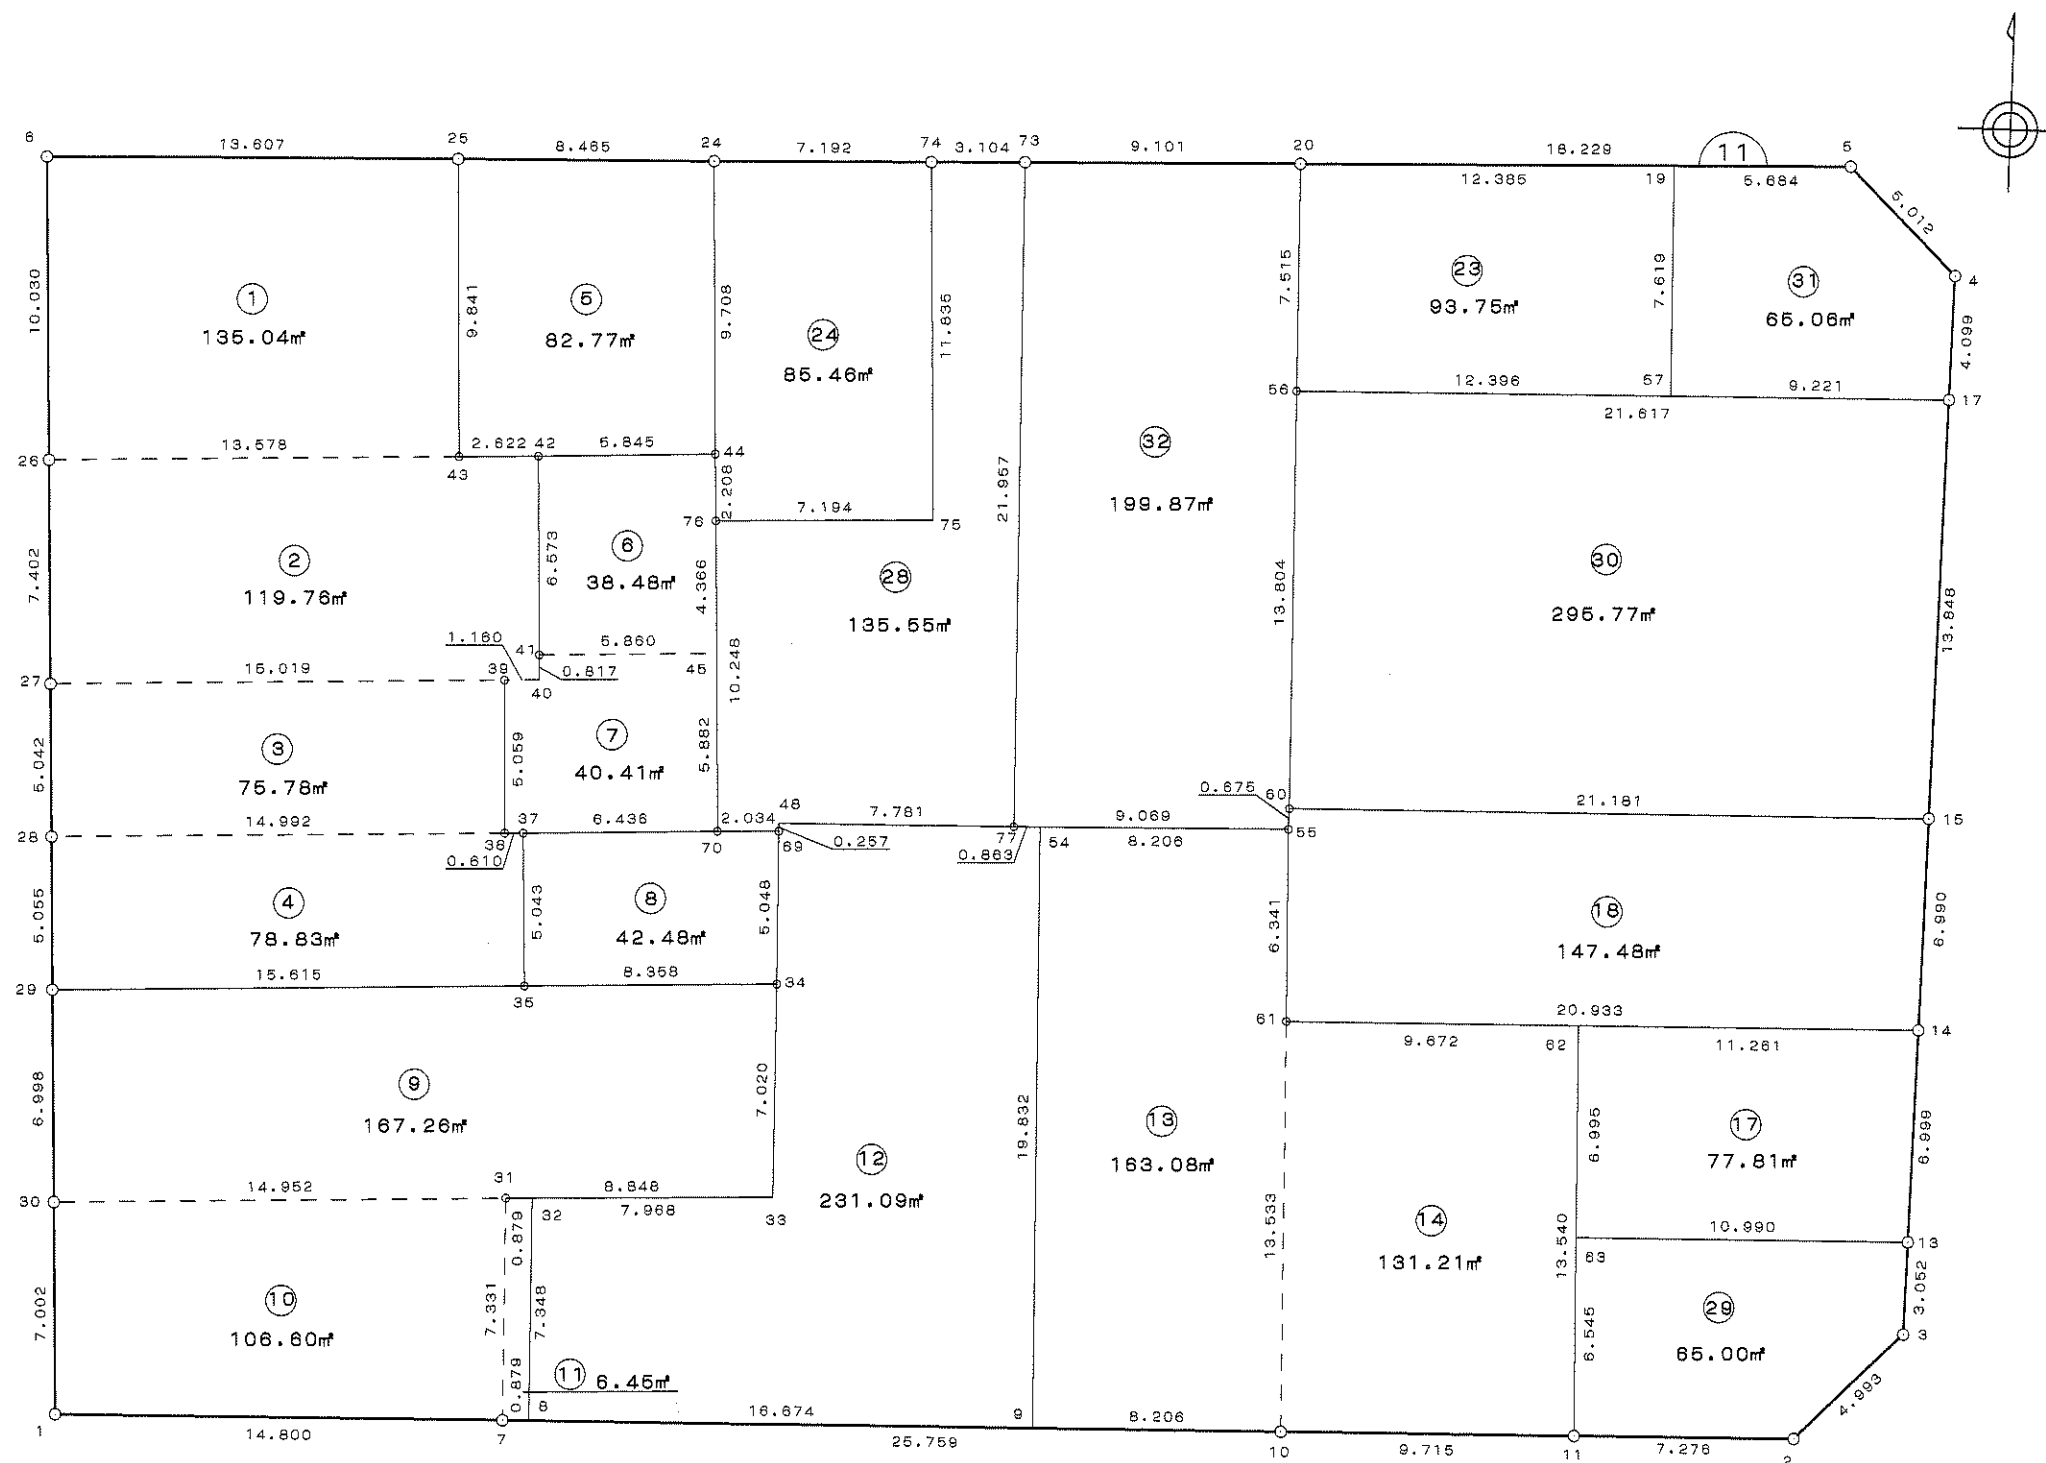

座標データリスト



現場名：佐野駅南地区 出来形

No	点 名	X	Y	No	点 名	X	Y	No	点 名	X	Y
1	11B1	34516.5235734	-22781.4450359	26	11B32	34523.1037368	-22765.4298983	51	11B74	34556.8526504	-22751.1162997
2	11B2	34513.7290448	-22723.9630191	27	11B33	34522.8692727	-22757.4649531	52	11B75	34545.0222331	-22751.4410576
3	11B3	34517.0415541	-22720.2273443	28	11B34	34529.8801065	-22757.1083686	53	11B76	34545.2314310	-22758.6321237
4	11B4	34551.9110590	-22717.3668337	29	11B35	34530.1089170	-22765.4636032	54	11B 77	34534.8036400	-22749.0930033
5	11B5	34555.6489720	-22720.7057819	30	11B37	34535.1499839	-22765.3433771				
6	11B6	34558.0378351	-22780.3563029	31	11B38	34535.1710752	-22765.9526481				
7	11B 7	34515.8068290	-22766.6626896	32	11B39	34540.2273528	-22765.7936121				
8	11B8	34515.7641197	-22765.7845008	33	11B40	34540.1971487	-22764.6341746				
9	11B9	34514.9541466	-22749.1298309	34	11B41	34541.0141000	-22764.6088648				
10	11B10	34514.5555386	-22740.9336526	35	11B42	34547.5840581	-22764.4227969				
11	11B11	34514.0775388	-22731.2308906	36	11B 43	34547.6561665	-22767.0437995				
12	11B 13	34520.0823207	-22719.9699382	37	11B44	34547.4392883	-22758.5791311				
13	11B14	34527.0574785	-22719.3951116	38	11B 45	34540.8669924	-22758.7502697				
14	11B 15	34534.0242525	-22718.8264967	39	11B48	34535.1790577	-22756.8647880				
15	11B17	34547.8258842	-22717.6988029	40	11B54	34534.7661002	-22748.2307434				
16	11B 19	34555.8816300	-22726.5450029	41	11B55	34534.4091849	-22740.0326731				
17	11B20	34556.3747249	-22738.9206367	42	11B56	34548.8690401	-22739.2902081				
18	11B24	34557.1433579	-22758.3029110	43	11B 57	34548.2708629	-22726.9090437				
19	11B 25	34557.4931545	-22766.7605240	44	11B 60	34535.0823325	-22739.9808241				
20	11B26	34548.0112346	-22780.6171638	45	11B61	34528.0742873	-22740.3032230				
21	11B27	34540.6121913	-22780.8079121	46	11B62	34527.6044685	-22730.6425826				
22	11B28	34535.5723343	-22780.9392538	47	11B 63	34520.6164870	-22730.9465012				
23	11B29	34530.5191541	-22781.0732134	48	11B69	34534.9223376	-22756.8766812				
24	11B30	34523.5231930	-22781.2561662	49	11B70	34534.9875015	-22758.9094284				
25	11B 31	34523.1296120	-22766.3089004	50	11B 73	34556.7339793	-22748.0143241				

略 図 S = 1 / 250

街区面積 2,032.24 m²

画地面積 2,032.19 m²

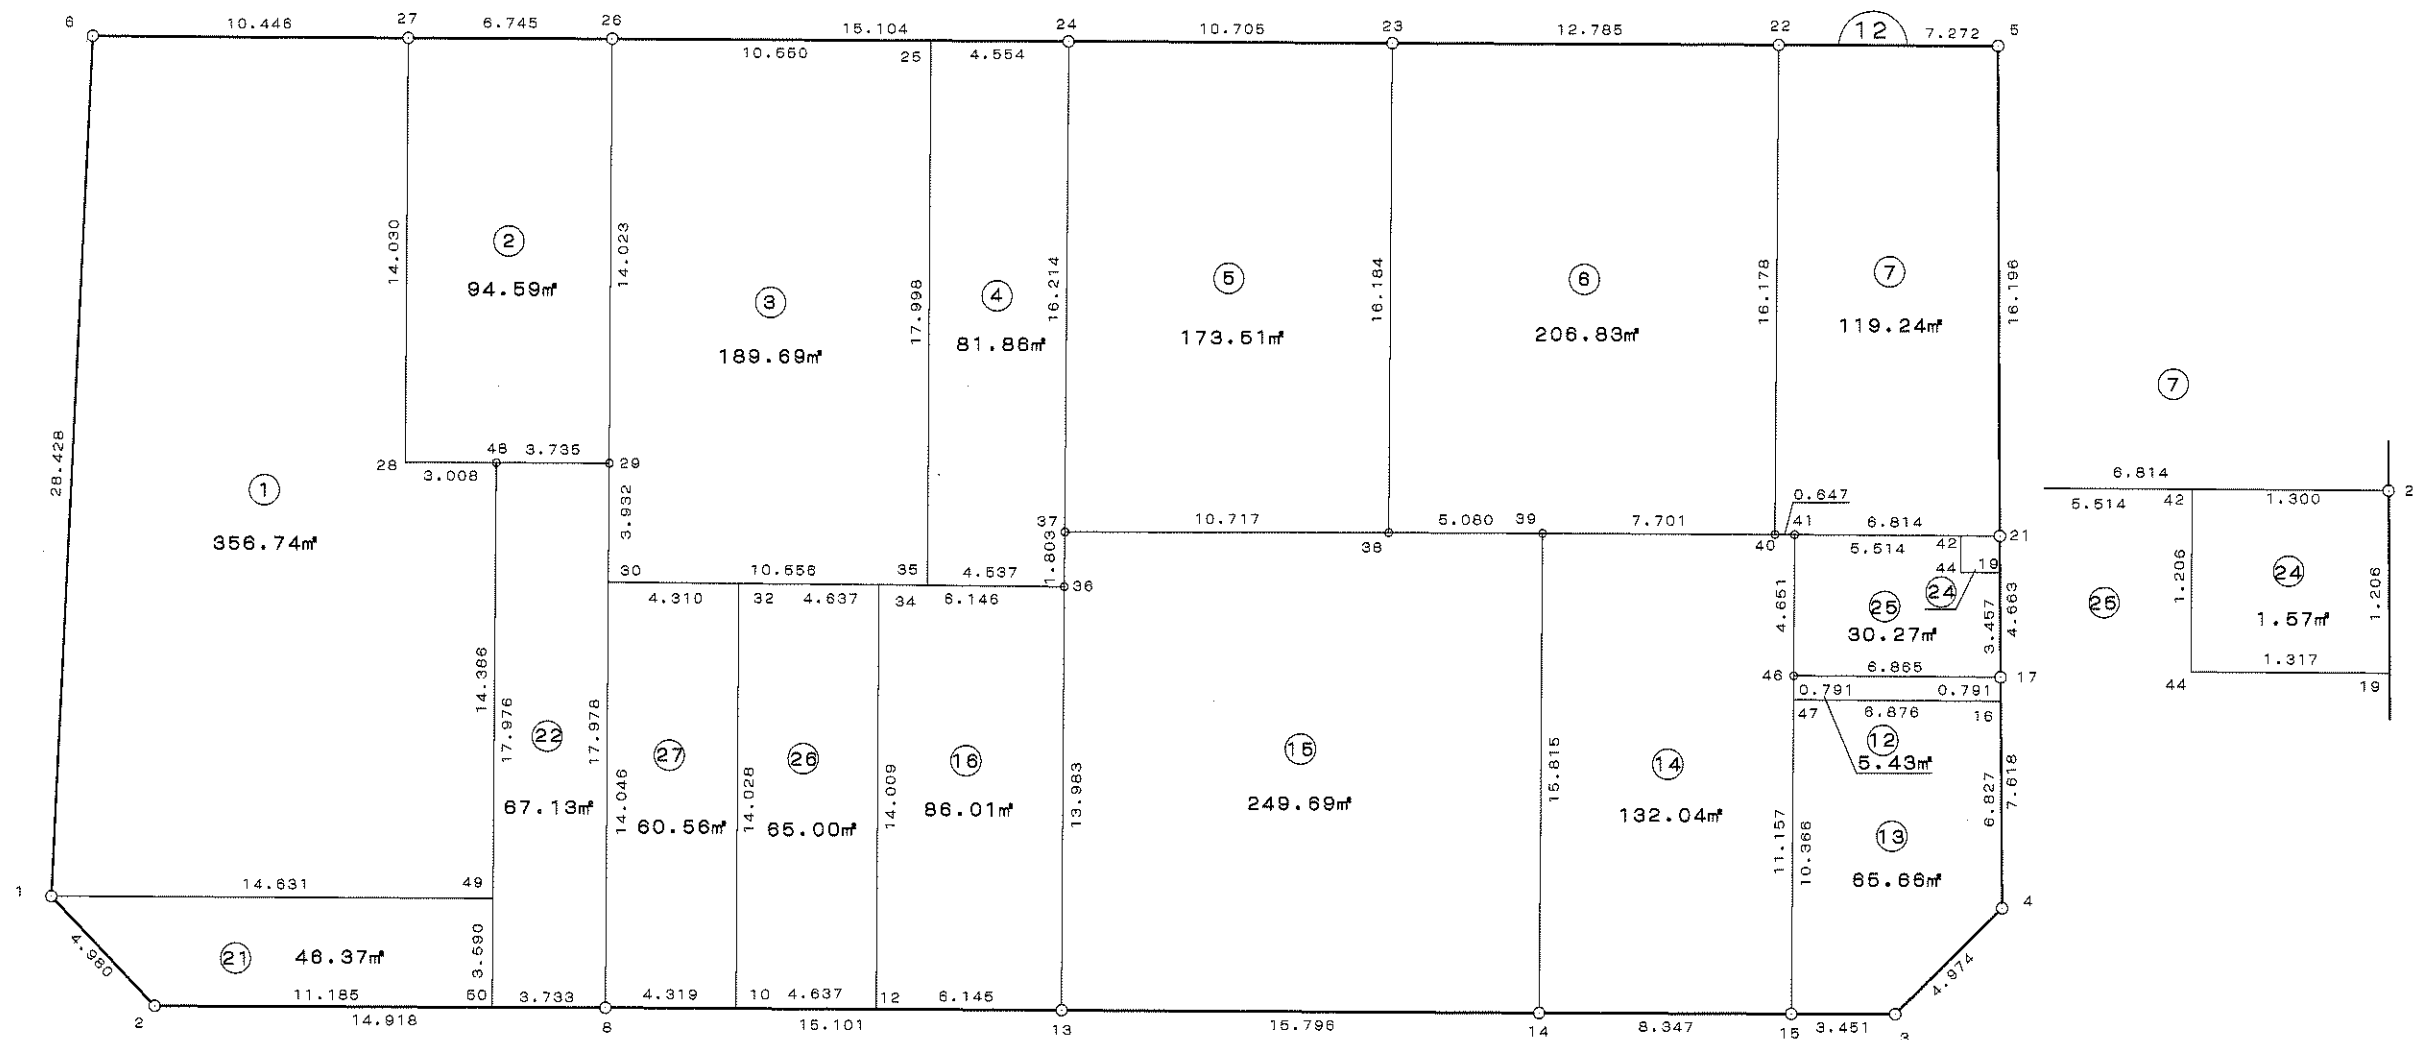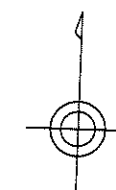

座標データリスト


現場名：佐野駅南地区 出来形

No	点 名	X	Y	No	点 名	X	Y
1	12B6	34593.1766833	-22707.9957798	26	12B37	34575.7000639	-22676.3817704
2	12B1	34564.8423099	-22710.3027959	27	12B38	34575.3077862	-22665.6715373
3	12B2	34561.1120709	-22707.0029321	28	12B39	34575.1052531	-22660.5959727
4	12B8	34560.5225076	-22692.0965200	29	12B40	34574.7992124	-22652.9007628
5	12B13	34559.9263922	-22677.0072128	30	12B41	34574.7696164	-22652.2544356
6	12B14	34559.3029701	-22661.2236081	31	12B46	34570.1224037	-22652.4345391
7	12B15	34558.9747670	-22652.8826584	32	12B 47	34569.3320668	-22652.4663095
8	12B3	34558.8396231	-22649.4343066	33	12B 16	34569.0327563	-22645.5966718
9	12B4	34562.2078156	-22645.7746774	34	12B 34	34574.1666163	-22682.5947319
10	12B17	34569.8235789	-22645.5760459	35	12B 12	34560.1689780	-22683.1477200
11	12B21	34574.4845632	-22645.4464006	36	12B 50	34560.6700532	-22695.8270369
12	12B5	34590.6743229	-22644.9894704	37	12B 42	34574.5389467	-22646.7452626
13	12B22	34590.9642213	-22652.2559106	38	12B 44	34573.3344276	-22646.7956959
14	12B23	34591.4788721	-22665.0300999	39	12B 19	34573.2793361	-22645.4799240
15	12B24	34591.9009388	-22675.7268211	40	12B 32	34574.3690565	-22687.2271750
16	12B26	34592.4974803	-22690.8188567	41	12B 10	34560.3520167	-22687.7809296
17	12B27	34592.7653413	-22697.5582971				
18	12B49	34564.2574046	-22695.6835229				
19	12B48	34578.6319064	-22695.1084627				
20	12B28	34578.7463737	-22698.1145786				
21	12B29	34578.4856344	-22691.3759213				
22	12B 30	34574.5572455	-22691.5335103				
23	12B 35	34574.0964026	-22680.9880296				
24	12B 25	34592.0807997	-22680.2771620				
25	12B36	34573.8983022	-22676.4548925				

略 図 $S = 1 / 250$

街区面積 $1,701.21 \text{ m}^2$

画地面積 $1,701.18 \text{ m}^2$

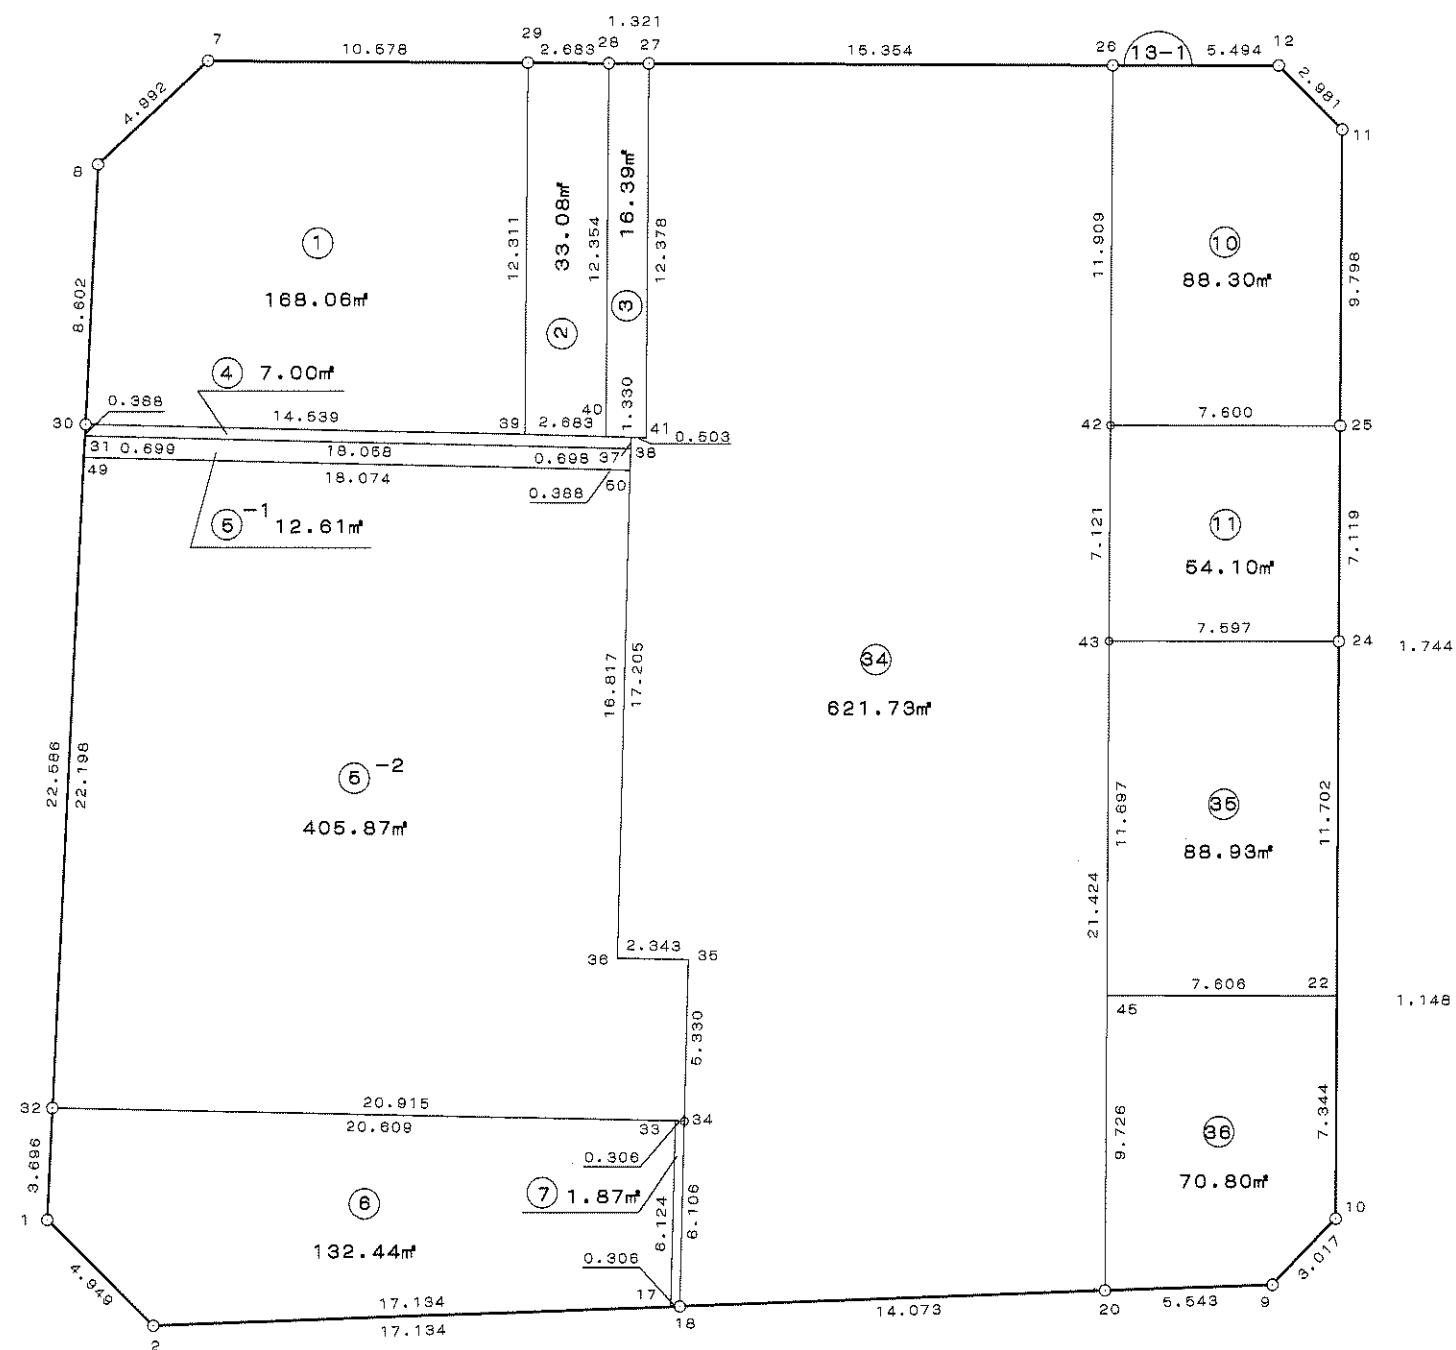

座標データリスト



現場名：佐野駅南地区 出来形

No	点 名	X	Y	No	点 名	X	Y
1	13-1B1	34517.0473042	-22714.1948234	26	13-1B37	34541.8138204	-22694.0651759
2	13-1B2	34513.4342806	-22710.8133194	27	13-1B38	34542.2008910	-22694.0424018
3	13-1B7	34555.1212226	-22707.6211851	28	13-1B39	34542.4035932	-22697.5465439
4	13-1B8	34551.8166959	-22711.3631299	29	13-1B40	34542.2486502	-22694.8680217
5	13-1B9	34513.5006817	-22673.7571300	30	13-1B 41	34542.1718186	-22693.5398235
6	13-1B10	34515.6089817	-22671.5988188	31	13-1B 42	34542.0319466	-22678.1740684
7	13-1B11	34551.5436151	-22670.1932901	32	13-1B43	34534.9163297	-22678.4520894
8	13-1B12	34553.7312103	-22672.2181108	33	13-1B 45	34523.2282009	-22678.9150582
9	13-1B17	34513.4742601	-22693.6797302	34	13-1B 49	34542.1603693	-22712.1497936
10	13-1B18	34513.4749750	-22693.3733478	35	13-1B 50	34541.1166111	-22694.1061975
11	13-1B20	34513.5094134	-22679.3000211				
12	13-1B 22	34522.9472761	-22671.3139778				
13	13-1B24	34534.6399800	-22670.8601173				
14	13-1B 25	34541.7531035	-22670.5791816				
15	13-1B26	34553.9319820	-22677.7087240				
16	13-1B 27	34554.5400940	-22693.0508166				
17	13-1B 28	34554.5930352	-22694.3704096				
18	13-1B29	34554.7042411	-22697.0511082				
19	13-1B30	34543.2432194	-22712.0612795				
20	13-1B31	34542.8566592	-22712.0928776				
21	13-1B 32	34520.7320269	-22713.9013845				
22	13-1B33	34519.5875193	-22693.3241697				
23	13-1B 34	34519.5705355	-22693.0188167				
24	13-1B35	34524.8915250	-22692.7133500				
25	13-1B36	34525.0254427	-22695.0529514				

街区面積 786.28 m²

画地面積 786.24 m²

略 $\square S = 1 / 250$

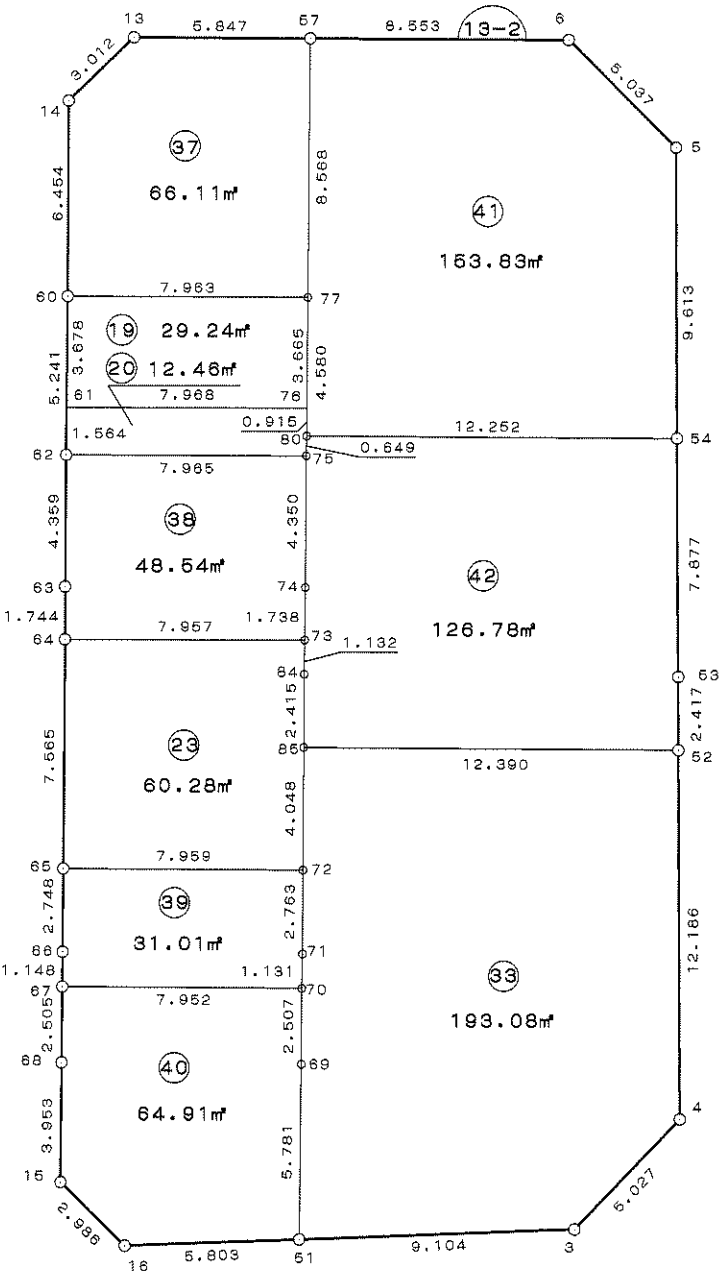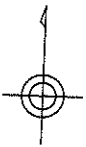

座標データリスト



現場名：佐野駅南地区 出来形

No	点 名	X	Y
1	13-2B3	34513.5624527	-22650.6278827
2	13-2B4	34517.0744338	-22647.0307292
3	13-2B5	34549.1549877	-22646.1527532
4	13-2B6	34552.8398565	-22649.5866166
5	13-2B13	34553.3998022	-22663.9764673
6	13-2B14	34551.3715114	-22666.2026141
7	13-2B15	34515.6793577	-22667.5953010
8	13-2B16	34513.5193168	-22665.5342063
9	13-2B51	34513.5388292	-22659.7316596
10	13-2B52	34529.2562252	-22646.6955117
11	13-2B 53	34531.6720939	-22646.6257235
12	13-2B54	34539.5460172	-22646.4171227
13	13-2B57	34553.1668212	-22658.1337214
14	13-2B 60	34544.9216948	-22666.4356508
15	13-2B61	34541.2472064	-22666.5859594
16	13-2B62	34539.6847650	-22666.6498726
17	13-2B 63	34535.3286010	-22666.8184802
18	13-2B64	34533.5861280	-22666.8843307
19	13-2B65	34526.0263911	-22667.1784137
20	13-2B 66	34523.2800600	-22667.2857329
21	13-2B67	34522.1326621	-22667.3323638
22	13-2B 68	34519.6293757	-22667.4323607
23	13-2B 69	34519.3144288	-22659.4842993
24	13-2B70	34521.8192458	-22659.3866256
25	13-2B 71	34522.9490918	-22659.3286535


No	点 名	X	Y
26	13-2B72	34525.7102422	-22659.2253026
27	13-2B73	34533.2985937	-22658.9324599
28	13-2B 74	34535.0351980	-22658.8579535
29	13-2B75	34539.3817821	-22658.6904011
30	13-2B76	34540.9441166	-22658.6236789
31	13-2B 77	34544.6057973	-22658.4788900
32	13-2B80	34540.0297220	-22658.6598384
33	13-2B 84	34532.1681141	-22658.9831425
34	13-2B85	34529.7551100	-22659.0749998

街区面積 4,029.63 m²
画地面積 4,029.63 m²

略 図 S = 1 / 250

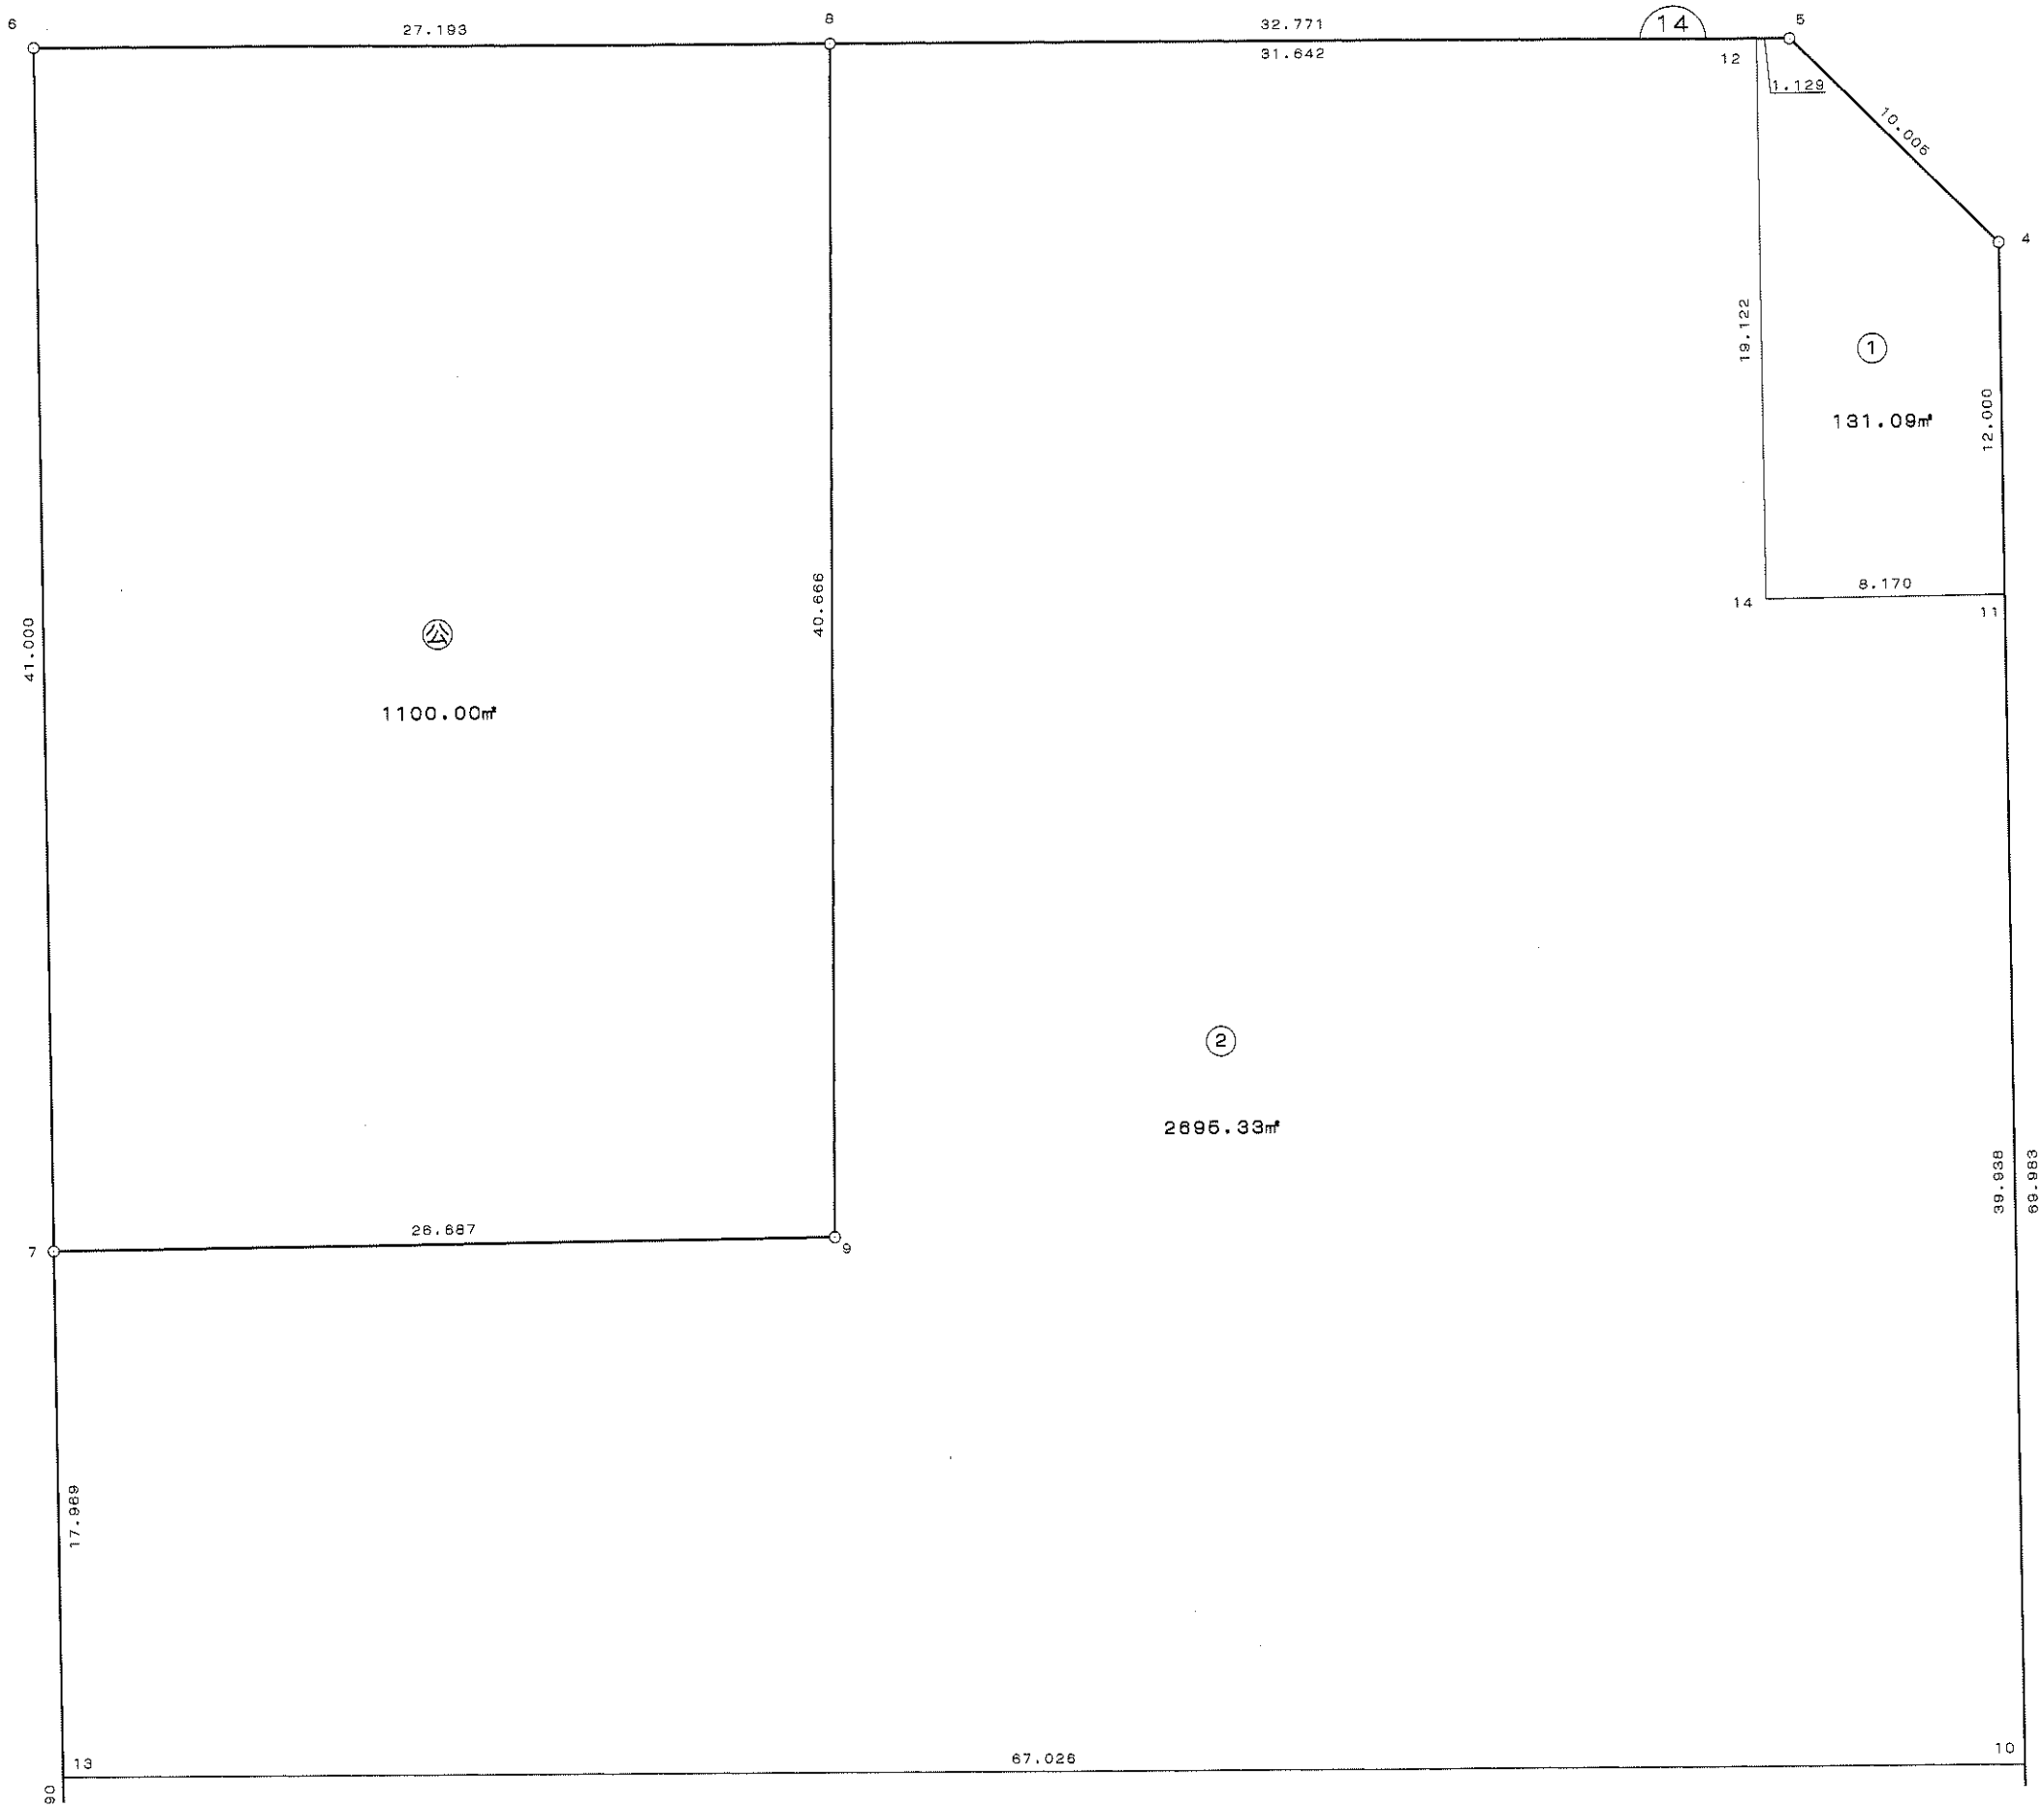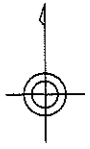

14B
②

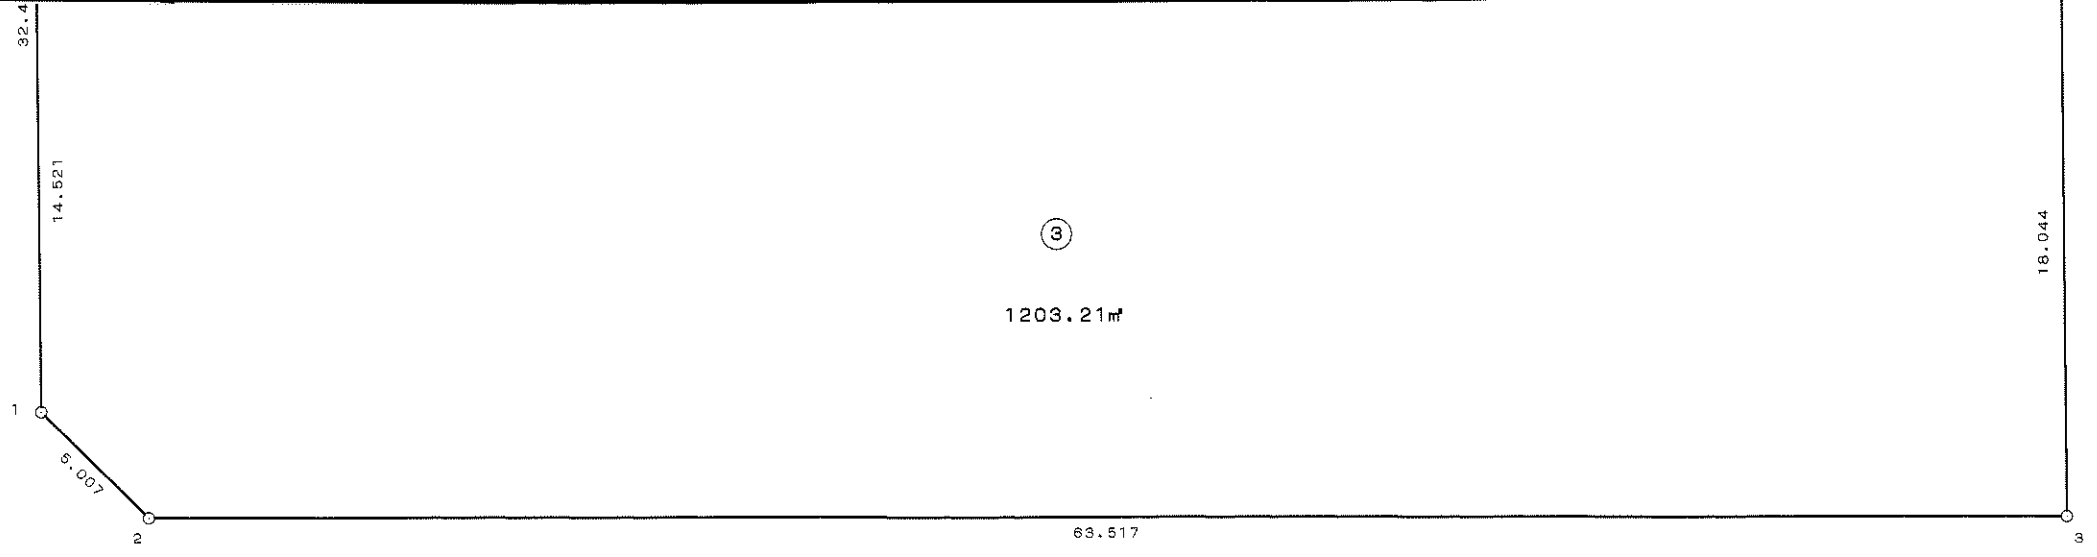

座標データリスト


現場名：佐野駅南地区 出来形

No	点 名	X	Y
1	14B1	34516.9762258	-22641.0400083
2	14B2	34513.3145080	-22637.6255007
3	14B3	34510.7792936	-22574.1586811
4	14B4	34580.7356995	-22572.2435961
5	14B5	34588.0332429	-22579.0876965
6	14B 7	34549.4537375	-22640.1399040
7	14B 8	34589.3474642	-22611.8325089
8	14B 9	34548.7144044	-22613.4633271
9	14B 10	34528.8168328	-22573.6648961
10	14B 11	34568.7401935	-22572.5719780
11	14B 12	34588.0785082	-22580.2155152
12	14B 13	34531.4920959	-22640.6377054
13	14B 14	34568.9637633	-22580.7387891

略 ☒ S = 1 / 250

街区面積 2,665.60 m²

画地面積 2,665.55 m²

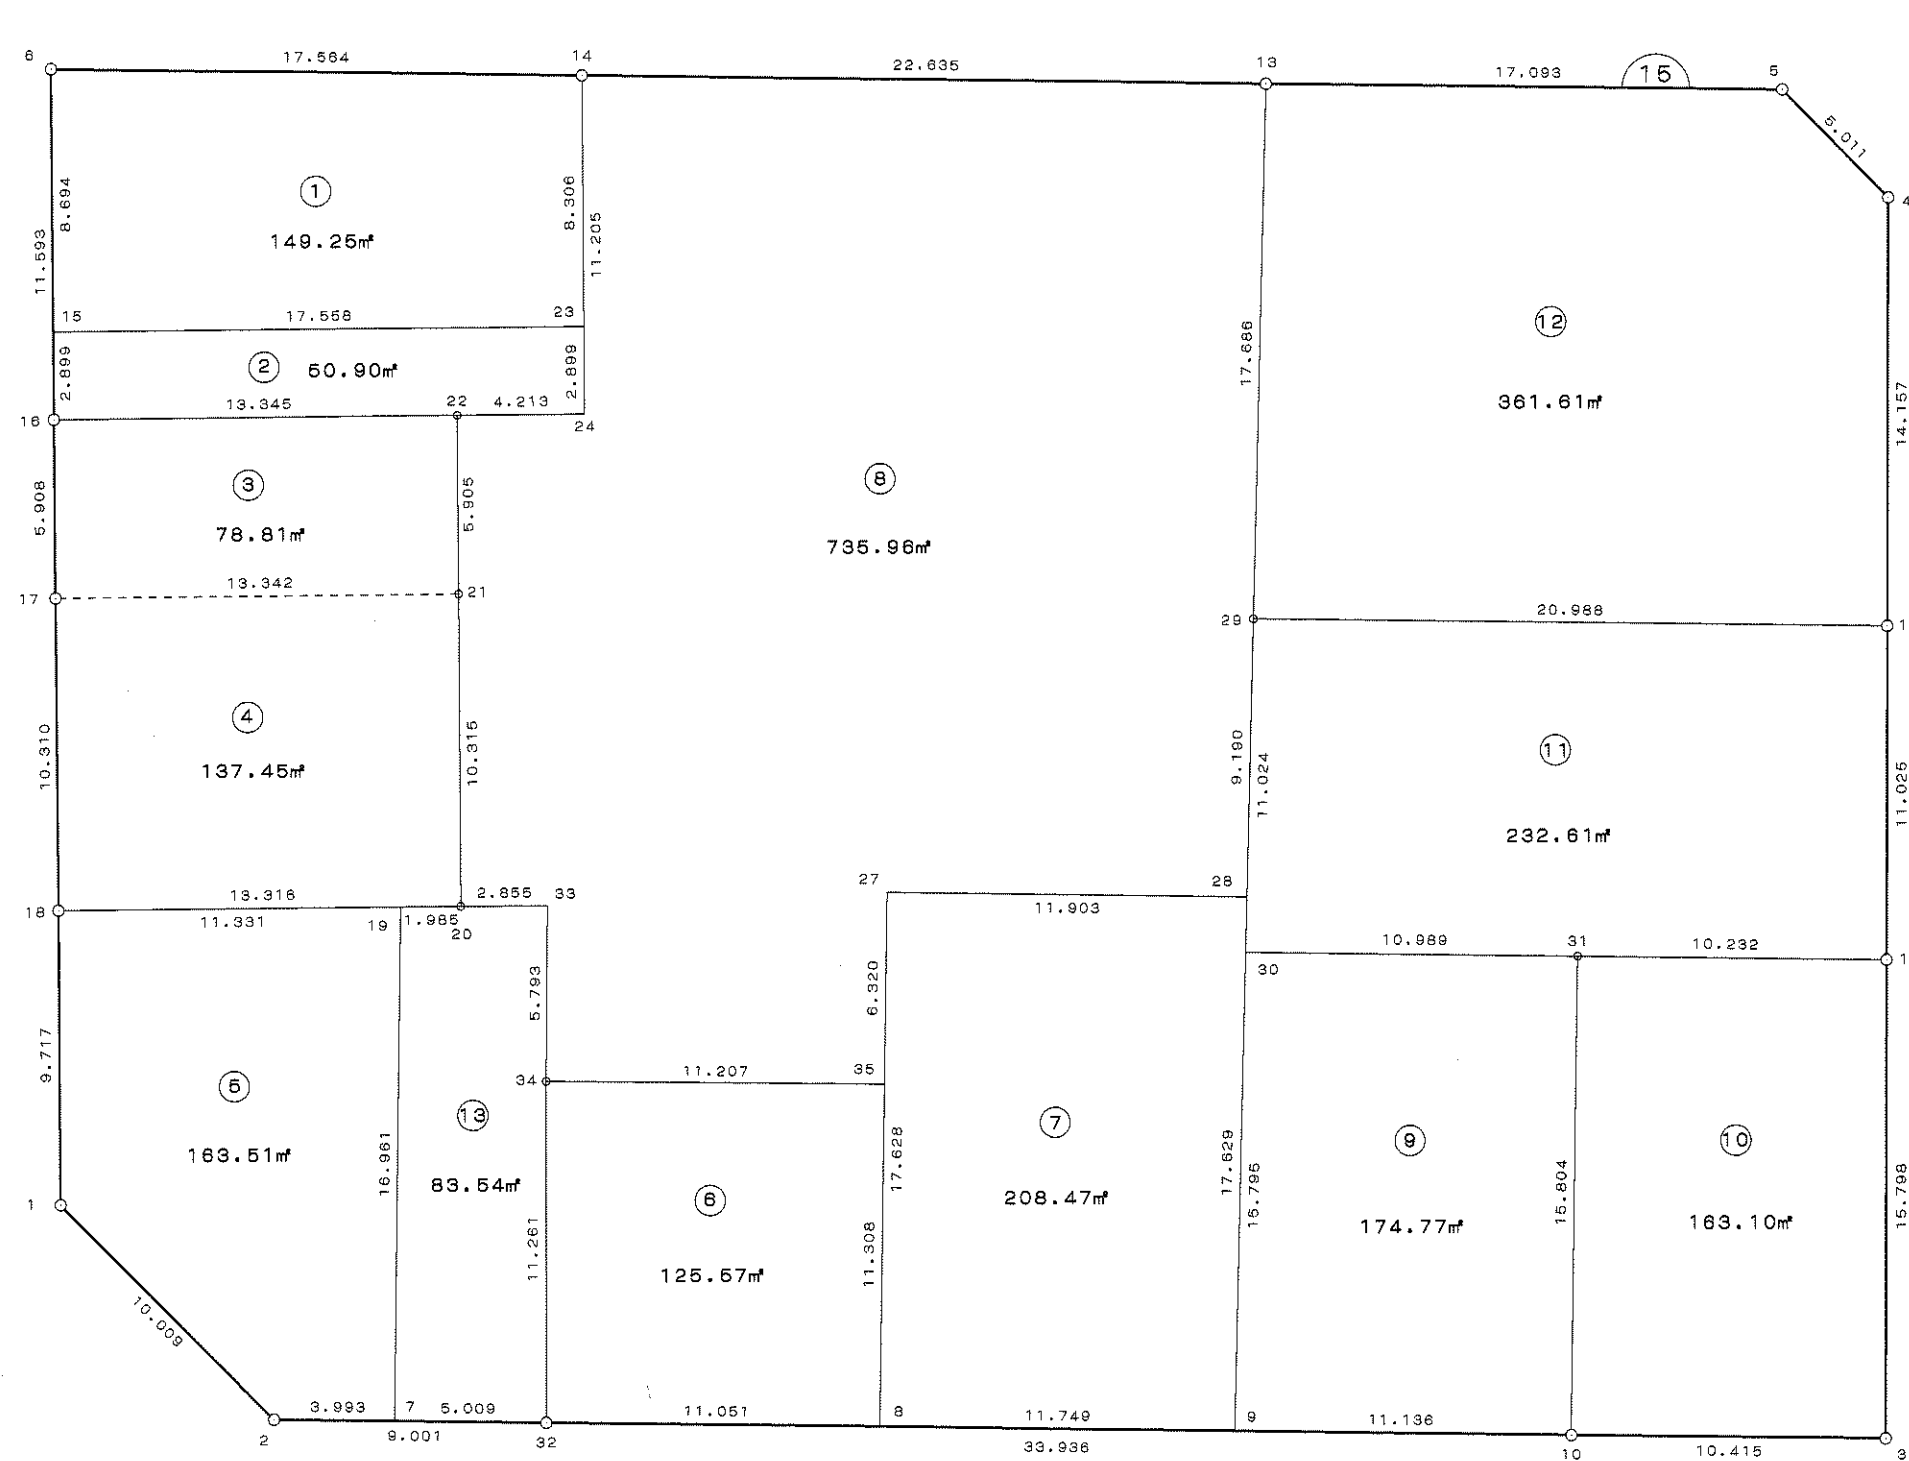

座標データリスト

現場名：佐野駅南地区 出来形


No	点 名	X	Y
1	15B1	34473.0302863	-22782.5980480
2	15B2	34465.6923367	-22775.7904523
3	15B3	34463.1061088	-22722.5017156
4	15B4	34504.0582143	-22720.9956812
5	15B5	34507.7513435	-22724.3828304
6	15B6	34510.5454511	-22781.6067186
7	15B 7	34465.5038009	-22771.8021741
8	15B 8	34464.7266564	-22755.7616572
9	15B 9	34464.1518553	-22744.0267263
10	15B10	34463.6070557	-22732.9042935
11	15B11	34478.8931607	-22721.9210516
12	15B12	34489.9112361	-22721.5174656
13	15B13	34508.5825745	-22741.4556122
14	15B14	34509.6993653	-22764.0633761
15	15B 15	34501.8546066	-22781.8357166
16	15B16	34498.9563329	-22781.9120841
17	15B17	34493.0506282	-22782.0640669
18	15B18	34482.7435411	-22782.3285981
19	15B 19	34482.4459028	-22771.0012789
20	15B20	34482.3937687	-22769.0171926
21	15B21	34492.7046146	-22768.7265544
22	15B22	34498.6079779	-22768.5716316
23	15B 23	34501.3962659	-22764.2833009
24	15B24	34498.4984281	-22764.3600561
25	15B 27	34482.3340175	-22754.8992125

No	点 名	X	Y
26	15B 28	34481.7517043	-22743.0109174
27	15B29	34490.9263465	-22742.4813854
28	15B30	34479.9206621	-22743.1165995
29	15B31	34479.3926729	-22732.1403614
30	15B32	34465.2672967	-22766.7991748
31	15B33	34482.3095971	-22766.1634616
32	15B34	34476.5213631	-22766.4040656
33	15B 35	34476.0213534	-22755.2084197


☒ S = 1 / 250

街区面積 6,101.13 m²

画地面積 6,101.10 m²

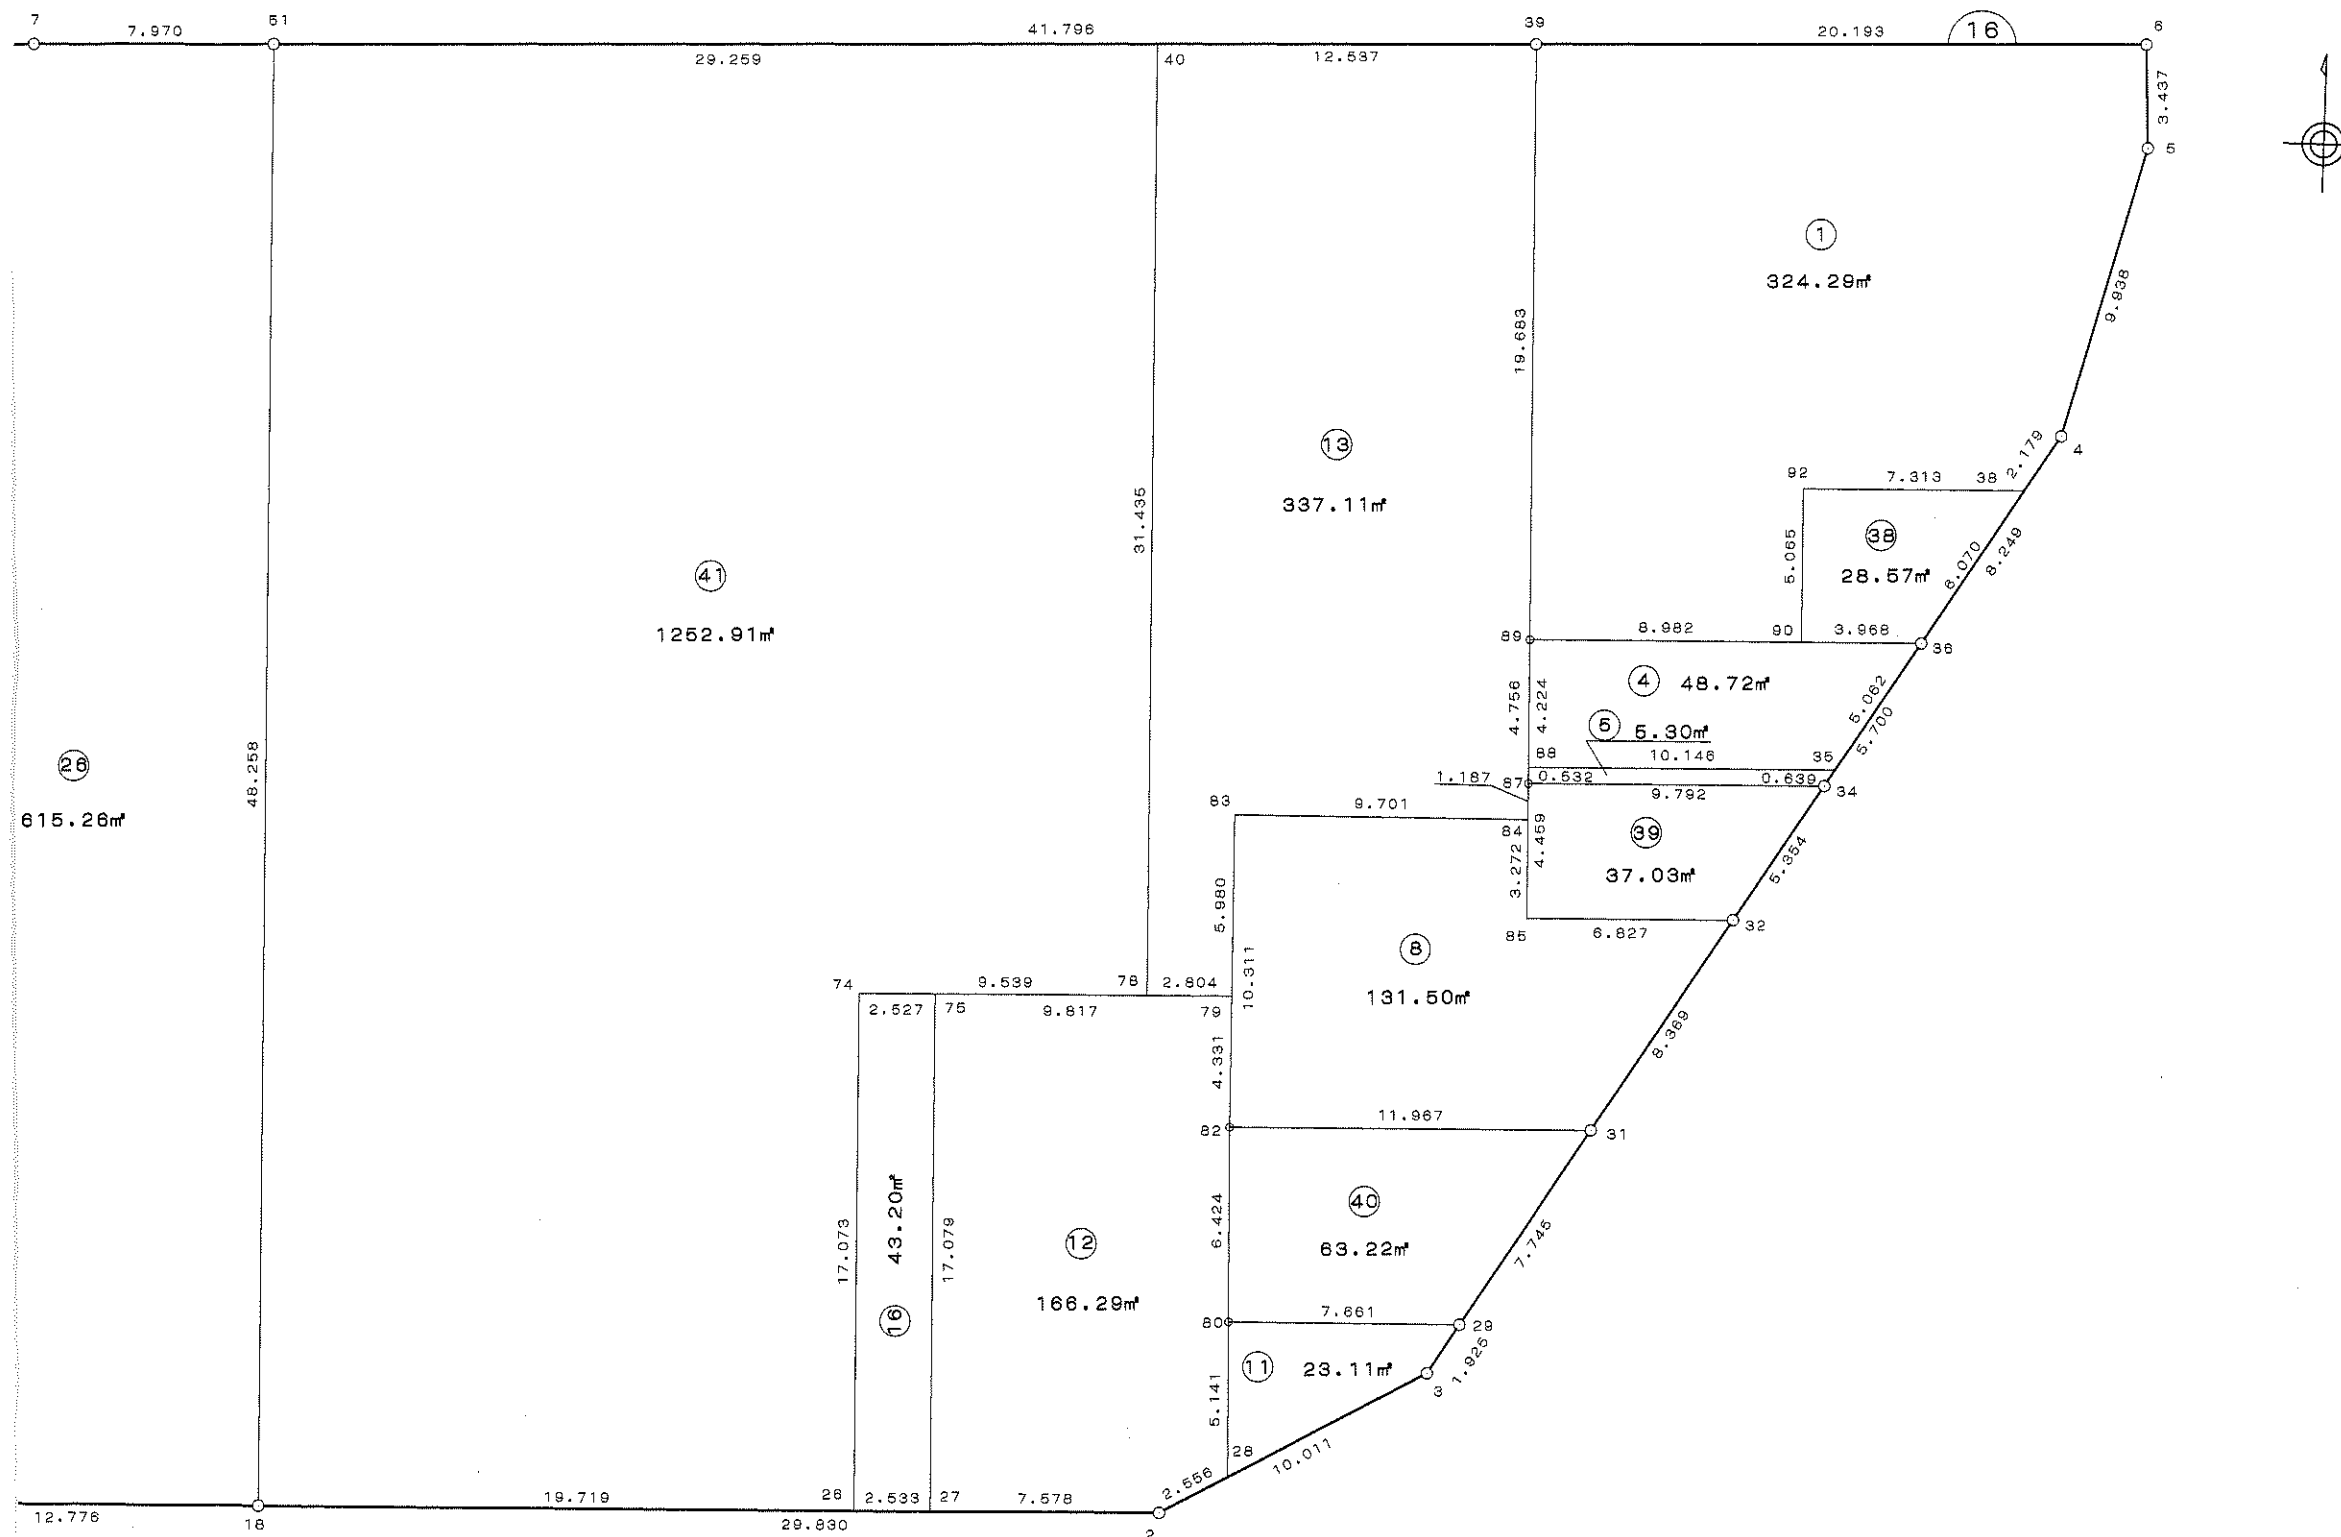

16B ②

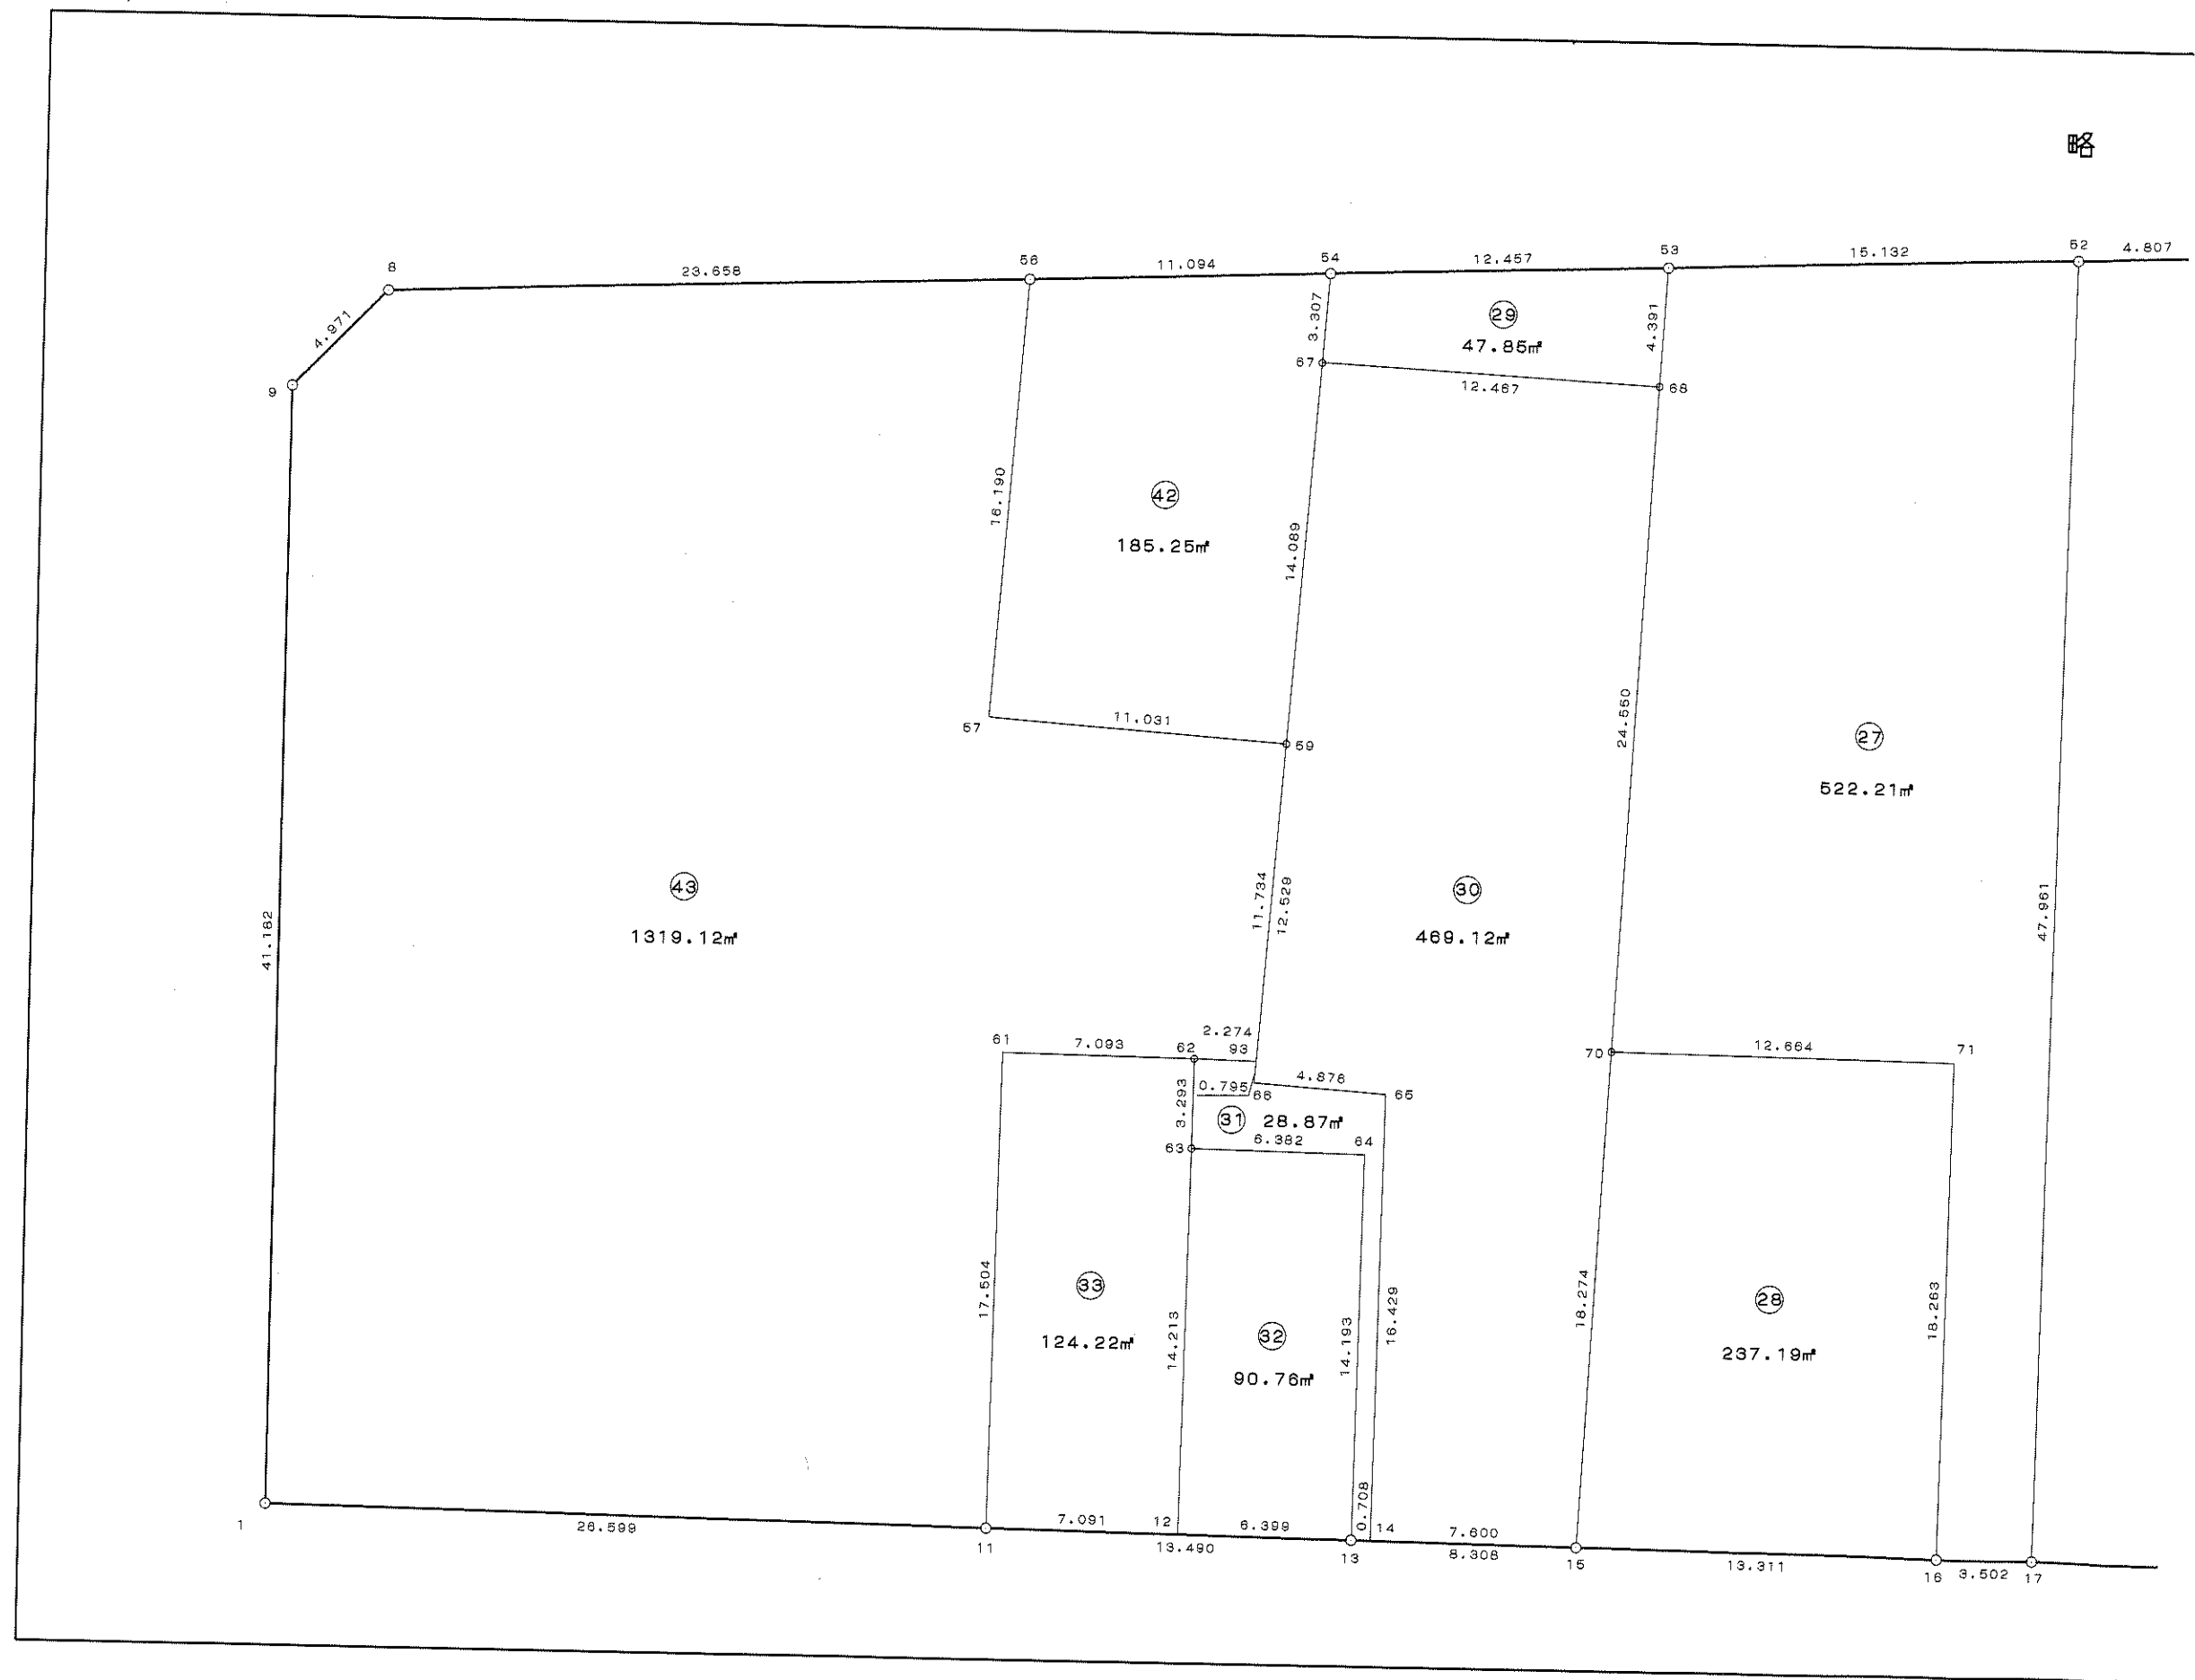

座標データリスト


現場名：佐野駅南地区 出来形

No	点 名	X	Y	No	点 名	X	Y	No	点 名	X	Y
1	16B9	34503.9765503	-22714.9864555	26	16B8	34507.4244715	-22711.4053031	51	16B59	34490.2016101	-22678.5023438
2	16B1	34462.8238734	-22716.5280633	27	16B 89	34485.9328357	-22595.4748544	52	16B66	34477.7446184	-22679.8449188
3	16B 11	34461.5267752	-22689.9611079	28	16B90	34485.4893576	-22586.5034088	53	16B65	34477.2457602	-22674.9944303
4	16B13	34460.8685426	-22676.4867625	29	16B92	34490.5485106	-22586.2533196	54	16B14	34460.8353510	-22675.7797283
5	16B15	34460.4789627	-22668.1880890	30	16B38	34490.1874603	-22578.9494911	55	16B62	34478.6665702	-22682.0299755
6	16B 16	34459.8256085	-22654.8932467	31	16B88	34481.7136642	-22595.6812286	56	16B 63	34475.3770515	-22682.1816100
7	16B17	34459.6590111	-22651.3949125	32	16B35	34481.2221488	-22585.5474690	57	16B 64	34475.0453208	-22675.8083752
8	16B18	34459.0402729	-22638.6340665	33	16B 87	34481.1826301	-22595.7072033	58	16B93	34478.5353499	-22679.7596962
9	16B2	34457.5881553	-22608.8398711	34	16B 82	34470.2342279	-22606.0187009	59	16B12	34461.1807684	-22682.8781775
10	16B3	34461.8657482	-22599.7885317	35	16B 85	34476.7290497	-22595.9275325	60	16B 61	34479.0103015	-22689.1147157
11	16B 29	34463.4180518	-22598.6507184	36	16B 84	34479.9970271	-22595.7658579	61	16B 57	34491.3689663	-22689.4710338
12	16B 31	34469.6590962	-22594.0650716	37	16B 83	34480.5296945	-22605.4525577				
13	16B 32	34476.4023982	-22589.1085810	38	16B 80	34463.8164812	-22606.3010209				
14	16B 34	34480.7082652	-22585.9270429	39	16B 28	34458.6801511	-22606.5292200				
15	16B 36	34485.2934502	-22582.5402521	40	16B 75	34475.0160769	-22615.5871187				
16	16B4	34491.9442329	-22577.6605378	41	16B 27	34457.9570330	-22616.4084133				
17	16B5	34501.3439696	-22574.4345360	42	16B 79	34474.5588849	-22605.7808899				
18	16B6	34504.7803919	-22574.3550486	43	16B40	34506.0873811	-22607.0583625				
19	16B39	34505.5930372	-22594.5315267	44	16B78	34474.6894894	-22608.5822023				
20	16B51	34507.2411294	-22636.2947252	45	16B74	34475.1337430	-22618.1109169				
21	16B7	34507.5597270	-22644.2578648	46	16B26	34458.0803486	-22618.9385725				
22	16B52	34507.5638179	-22649.0647143	47	16B 68	34503.1501428	-22664.5792638				
23	16B53	34507.5245897	-22664.1962893	48	16B70	34478.6881099	-22666.6498968				
24	16B54	34507.4992565	-22676.6534094	49	16B 71	34478.0670590	-22654.0010520				
25	16B 56	34507.4674648	-22687.7474812	50	16B 67	34504.2108472	-22677.0010720				


略 ☒ S = 1 / 250

街区面積 888.34 m²

画地面積 888.32 m²

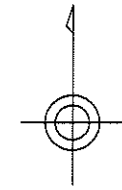

駅前広場

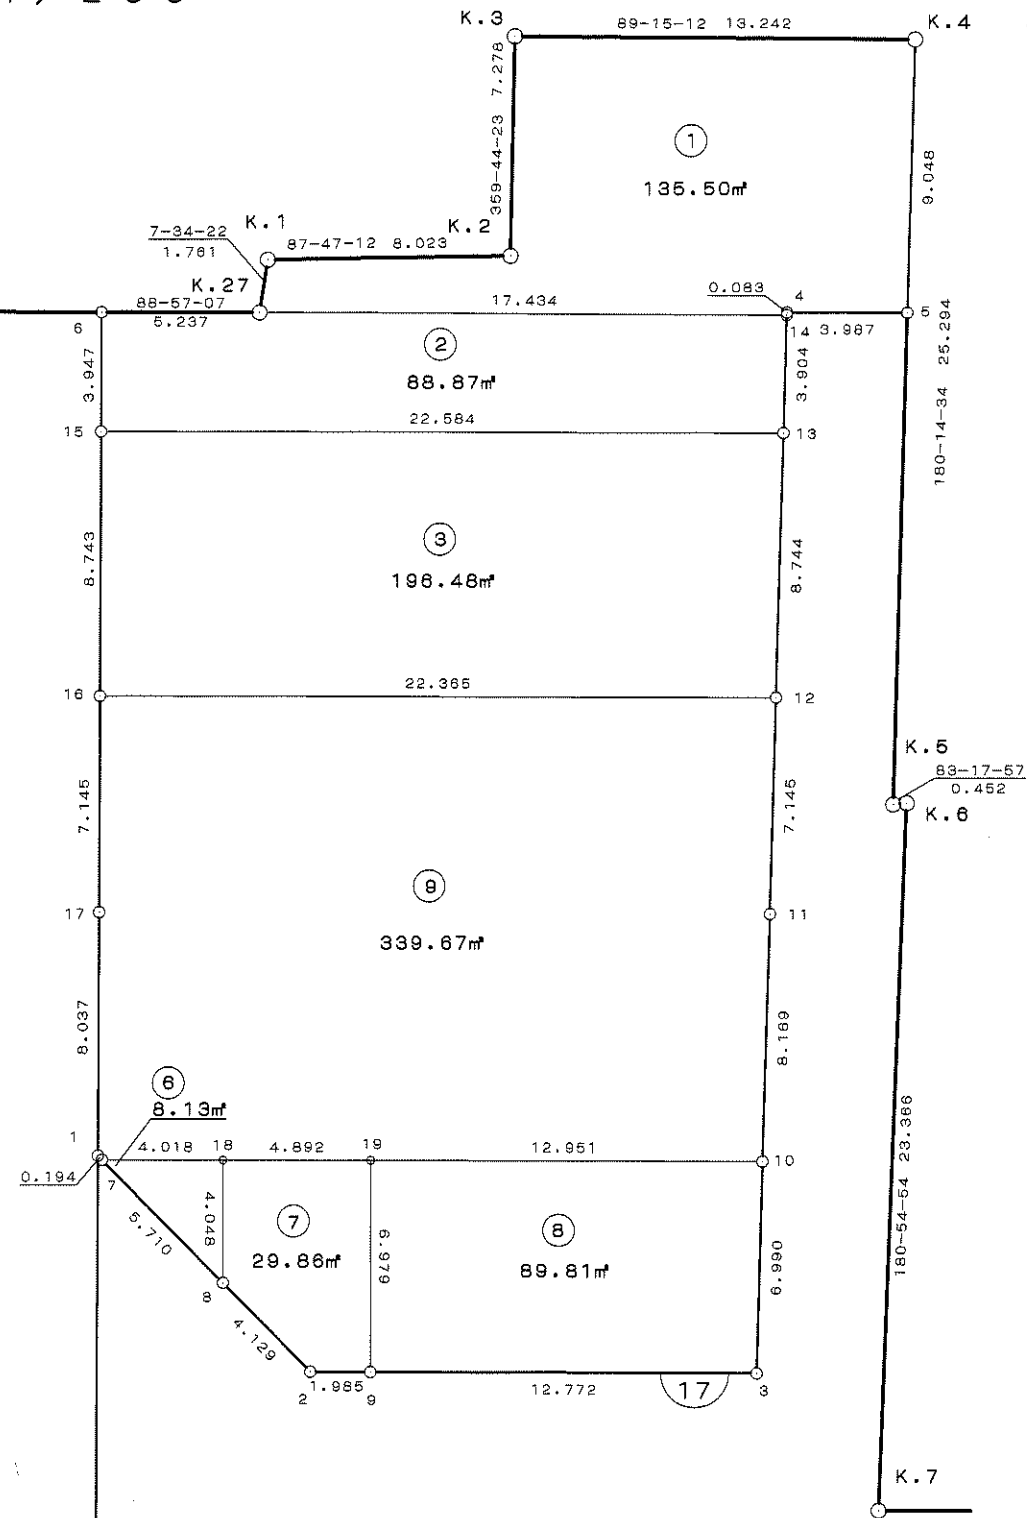

座標データリスト

現場名：佐野駅南地区 出来形


No	点 名	X	Y
1	17B1	34747.6504122	-22506.7901913
2	17B2	34740.6811785	-22499.5739511
3	17B3	34740.9598050	-22484.8190632
4	17B4	34775.9952212	-22484.6695084
5	17B5	34776.0713314	-22480.6831936
6	17B6	34775.5170793	-22507.3384053
7	17B7	34747.5158488	-22506.6510864
8	17B8	34743.5498058	-22502.5436048
9	17B9	34740.7174512	-22497.5890078
10	17B10	34747.9492645	-22484.7935576
11	17B11	34756.1185142	-22484.7494225
12	17B12	34763.2635046	-22484.7218664
13	17B13	34772.0074829	-22484.6805562
14	17B14	34775.9117490	-22484.6703896
15	17B15	34771.5707845	-22507.2607392
16	17B16	34762.8295903	-22507.0828979
17	17B17	34755.6860289	-22506.9392998
18	17B18	34747.5963387	-22502.6339384
19	17B19	34747.6948260	-22497.7424477
20	K.1	34777.3582623	-22501.8697843
21	K.2	34777.6681216	-22493.8523394
22	K.3	34784.9462541	-22493.8853938
23	K.4	34785.1188415	-22480.6446946
24	K.27	34775.6128810	-22502.1018197

略 図 S = 1 / 2 5 0

街区面積 1,695.63 m²

画地面積 1,695.54 m²

駅前広場

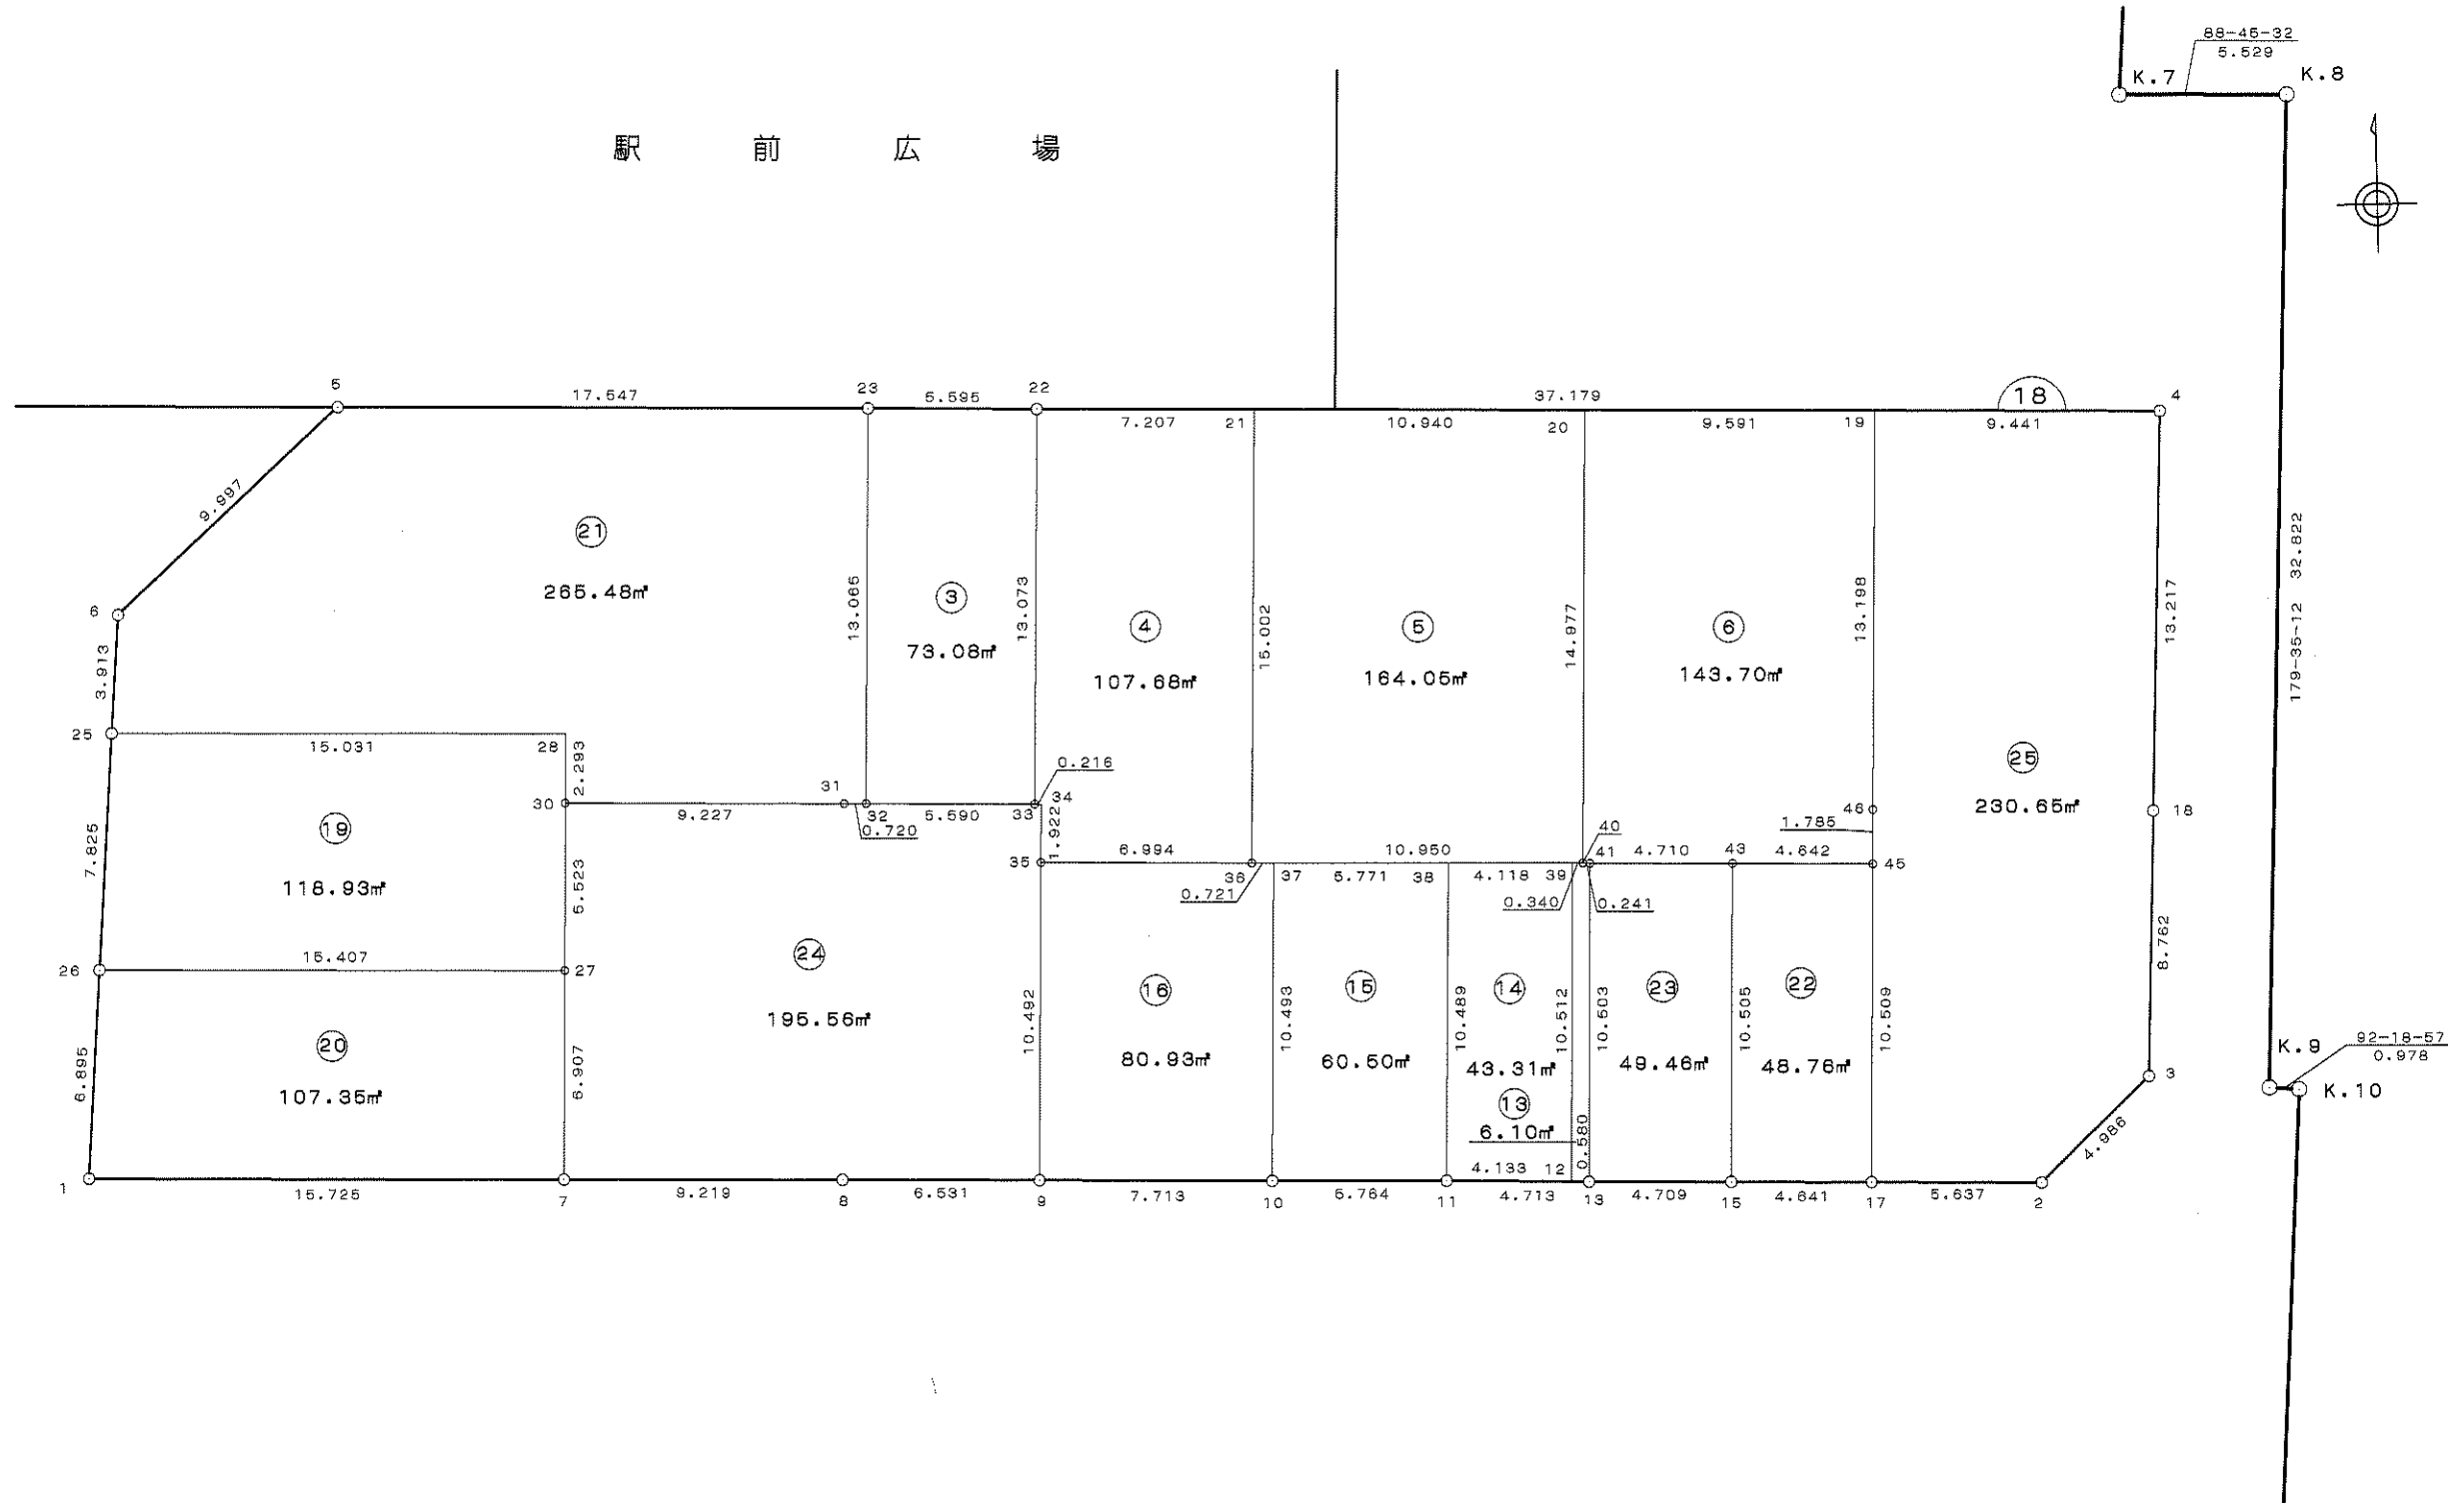

座標データリスト


現場名：佐野駅南地区 出来形

No	点 名	X	Y	No	点 名	X	Y
1	18B1	34699.2188560	-22547.0128403	26	18B30	34711.9625838	-22531.5402085
2	18B2	34700.5161486	-22482.3755436	27	18B31	34712.1460772	-22522.3150333
3	18B3	34704.1047685	-22478.9146133	28	18B32	34712.1618994	-22521.5953604
4	18B4	34726.0833706	-22479.0828410	29	18B33	34712.2654442	-22516.0061624
5	18B5	34724.8783249	-22539.3914952	30	18B34	34712.2693721	-22515.7901981
6	18B6	34717.8444022	-22546.4956044	31	18B35	34710.3474547	-22515.7556979
7	18B7	34699.5353268	-22531.2913971	32	18B36	34710.4813086	-22508.7628992
8	18B8	34699.7313136	-22522.0748623	33	18B 37	34710.4974987	-22508.0420810
9	18B9	34699.8572851	-22515.5452937	34	18B 38	34710.6270868	-22502.2725361
10	18B10	34700.0064889	-22507.8340378	35	18B 39	34710.7195557	-22498.1556200
11	18B 11	34700.1403237	-22502.0717967	36	18B40	34710.7271931	-22497.8155898
12	18B 12	34700.2096202	-22497.9393502	37	18B 41	34710.7197436	-22497.5751451
13	18B 13	34700.2193508	-22497.3590716	38	18B 43	34710.8175701	-22492.8661611
14	18B 15	34700.3150063	-22492.6514450	39	18B 45	34710.9140900	-22488.2249899
15	18B 17	34700.4075686	-22488.0111102	40	18B 46	34712.6981691	-22488.2640635
16	18B 18	34712.8663434	-22478.9767113				
17	18B 19	34725.8935811	-22488.5221752				
18	18B 20	34725.7007860	-22498.1109952				
19	18B 21	34725.4808682	-22509.0487845				
20	18B 22	34725.3359966	-22516.2540865				
21	18B23	34725.2245662	-22521.8478784				
22	18B25	34713.9330972	-22546.6124311				
23	18B26	34706.1113412	-22546.8246440				
24	18B27	34706.4408983	-22531.4215624				
25	18B28	34714.2549997	-22531.5843786				

$S = 1 / 250$


街区面積 2,880.27 m²

画地面積 2,880.19 m²

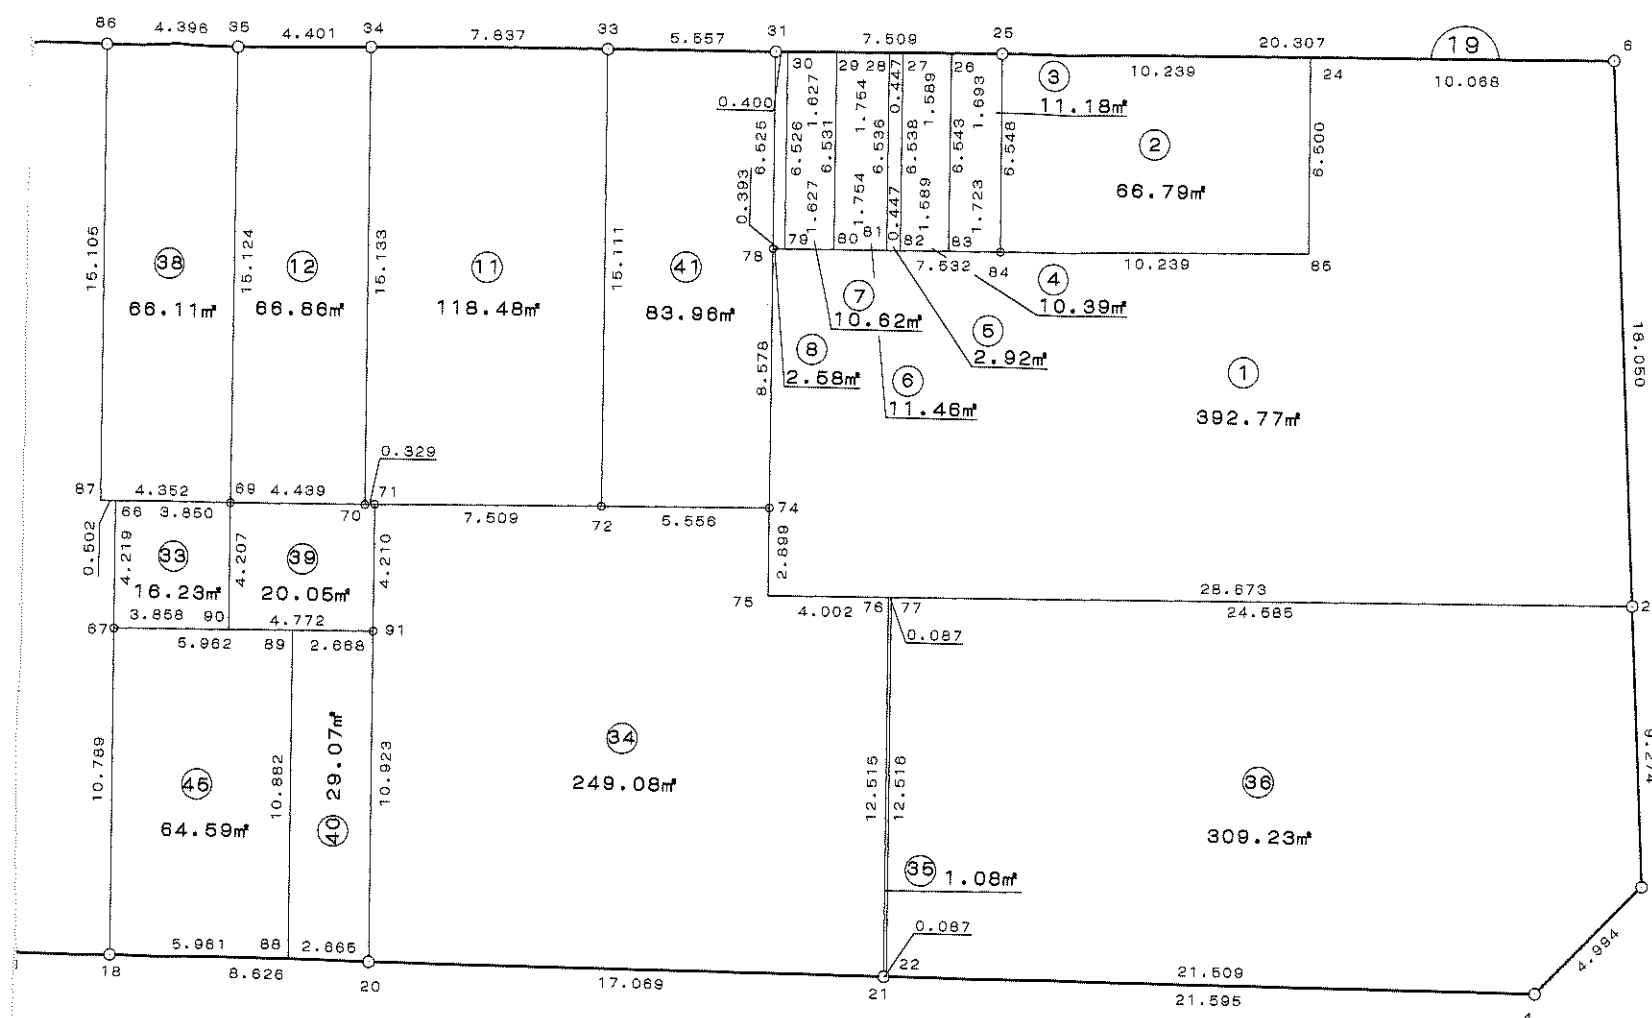

198②

略

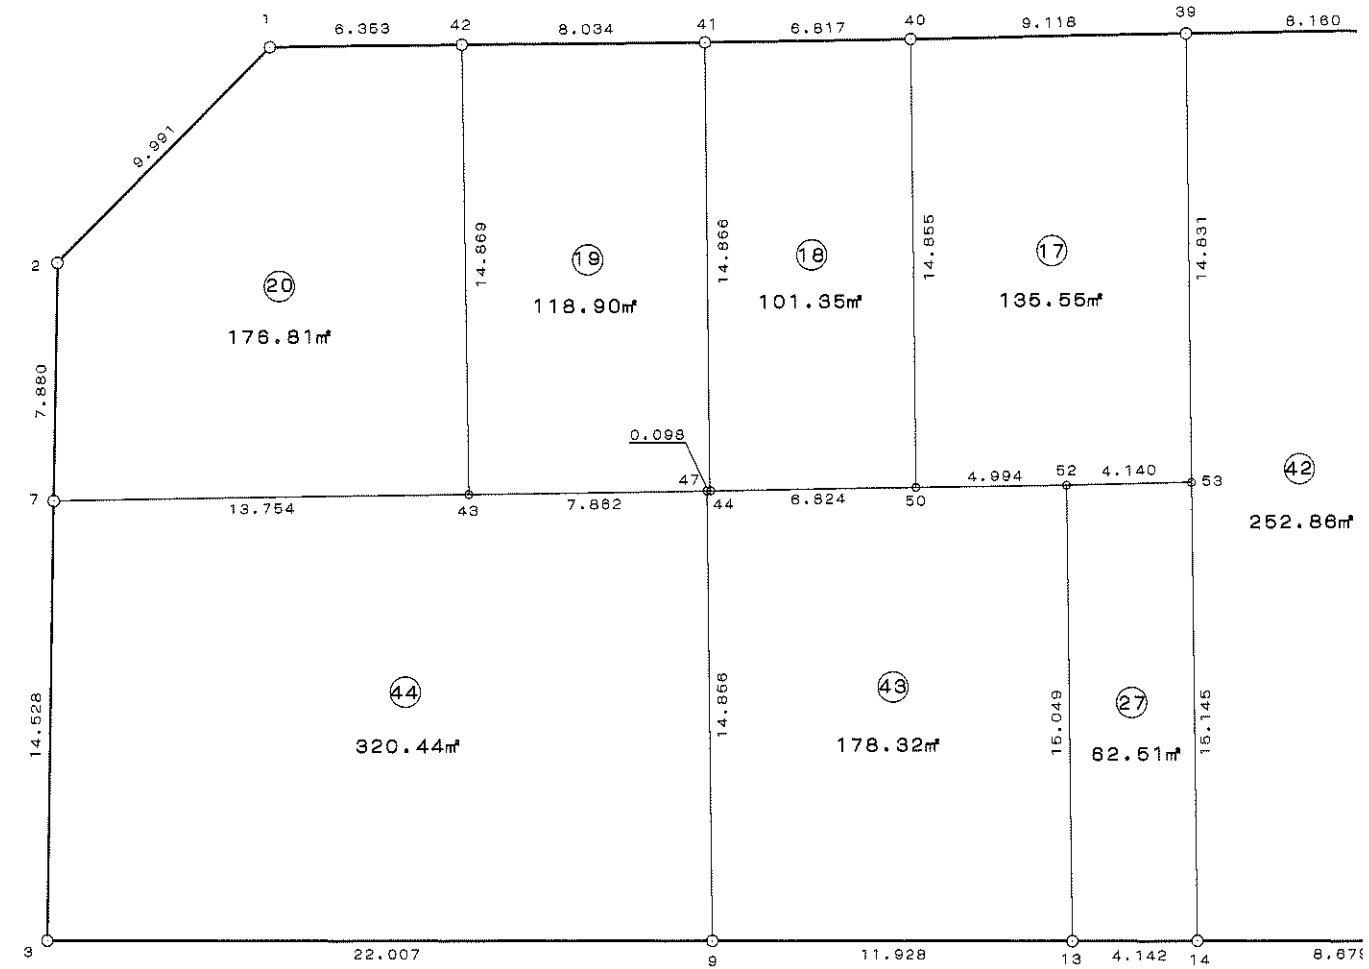



座標データリスト

現場名：佐野駅南地区 出来形

No	点 名	X	Y	No	点 名	X	Y	No	点 名	X	Y
1	19B1	34604.7872926	-22549.6366159	26	19B 85	34683.0252338	-22540.9669222	51	19B66	34643.3469716	-22533.4477284
2	19B2	34597.4716489	-22542.8321801	27	19B84	34672.7888385	-22541.1978642	52	19B 67	34643.2228480	-22529.2302695
3	19B7	34597.0276523	-22534.9646956	28	19B78	34665.2606302	-22541.4330607	53	19B 90	34647.0790673	-22529.1233748
4	19B3	34596.2237916	-22520.4592821	29	19B74	34665.0217896	-22532.8583854	54	19B 76	34668.9402170	-22529.8465363
5	19B9	34618.2110288	-22519.5170251	30	19B 75	34664.9398612	-22529.9603892	55	19B91	34651.8495092	-22528.9911379
6	19B 13	34630.1282913	-22519.0002370	31	19B 26	34671.2509165	-22547.7917579	56	19B77	34669.0270381	-22529.8440654
7	19B 14	34634.2661952	-22518.8220424	32	19B 83	34671.0665235	-22541.2516728	57	19B22	34668.6953373	-22517.3327048
8	19B 18	34642.9374669	-22518.4447714	33	19B 27	34669.6629055	-22547.8365307	58	19B87	34642.8451363	-22533.4632259
9	19B20	34651.5551143	-22518.0717537	34	19B 82	34669.4786489	-22541.3012813	59	19B 89	34649.1824065	-22529.0650702
10	19B 21	34668.6085491	-22517.3364202	35	19B 28	34669.2163849	-22547.8491200	60	19B 88	34648.8927100	-22518.1869967
11	19B4	34690.1842171	-22516.4127616	36	19B 81	34669.0321666	-22541.3152303				
12	19B5	34693.7854164	-22519.8720804	37	19B 29	34667.4631080	-22547.8985524				
13	19B 23	34693.6016646	-22529.1446549	38	19B 80	34667.2790403	-22541.3700015				
14	19B6	34693.2423134	-22547.1908585	39	19B 30	34665.8370611	-22547.9443976				
15	19B25	34672.9433394	-22547.7440412	40	19B 79	34665.6531330	-22541.4207982				
16	19B31	34665.4372974	-22547.9556686	41	19B70	34651.6319974	-22533.2006255				
17	19B 33	34659.8825559	-22548.1068179	42	19B71	34651.9606578	-22533.2001435				
18	19B34	34652.0486973	-22548.3278873	43	19B 72	34659.4671938	-22533.0015157				
19	19B 35	34647.6488662	-22548.4460722	44	19B69	34647.1951166	-22533.3288912				
20	19B86	34643.2544768	-22548.5626784	45	19B50	34625.5545751	-22534.1873688				
21	19B 39	34635.0974191	-22548.7856637	46	19B 52	34630.5469432	-22534.0435054				
22	19B40	34625.9826975	-22549.0361983	47	19B 53	34634.6862155	-22533.9607249				
23	19B 41	34619.1679358	-22549.2257514	48	19B 44	34618.7326519	-22534.3665796				
24	19B42	34611.1372115	-22549.4527078	49	19B43	34610.7760631	-22534.5880944				
25	19B 24	34683.1785394	-22547.4651140	50	19B47	34618.6345403	-22534.3667116				

街区面積 3,317.09 m²


画地面積 3,317.01 m²

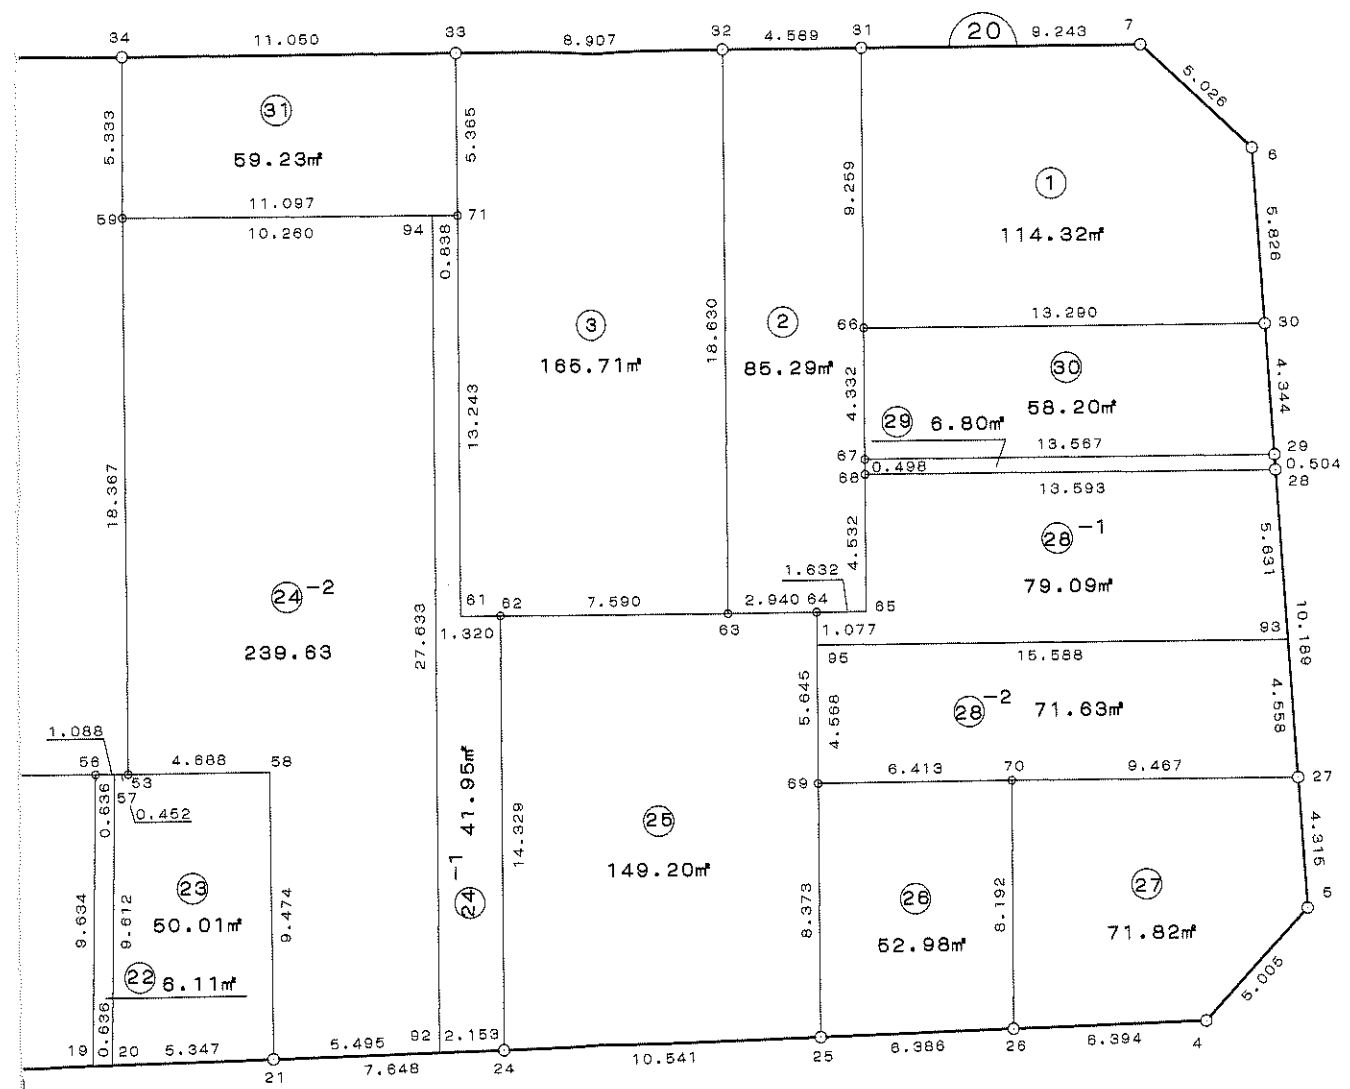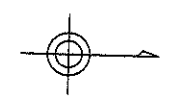

180-45-55 74.196

208 ②

略 ☒ S = 1 / 250

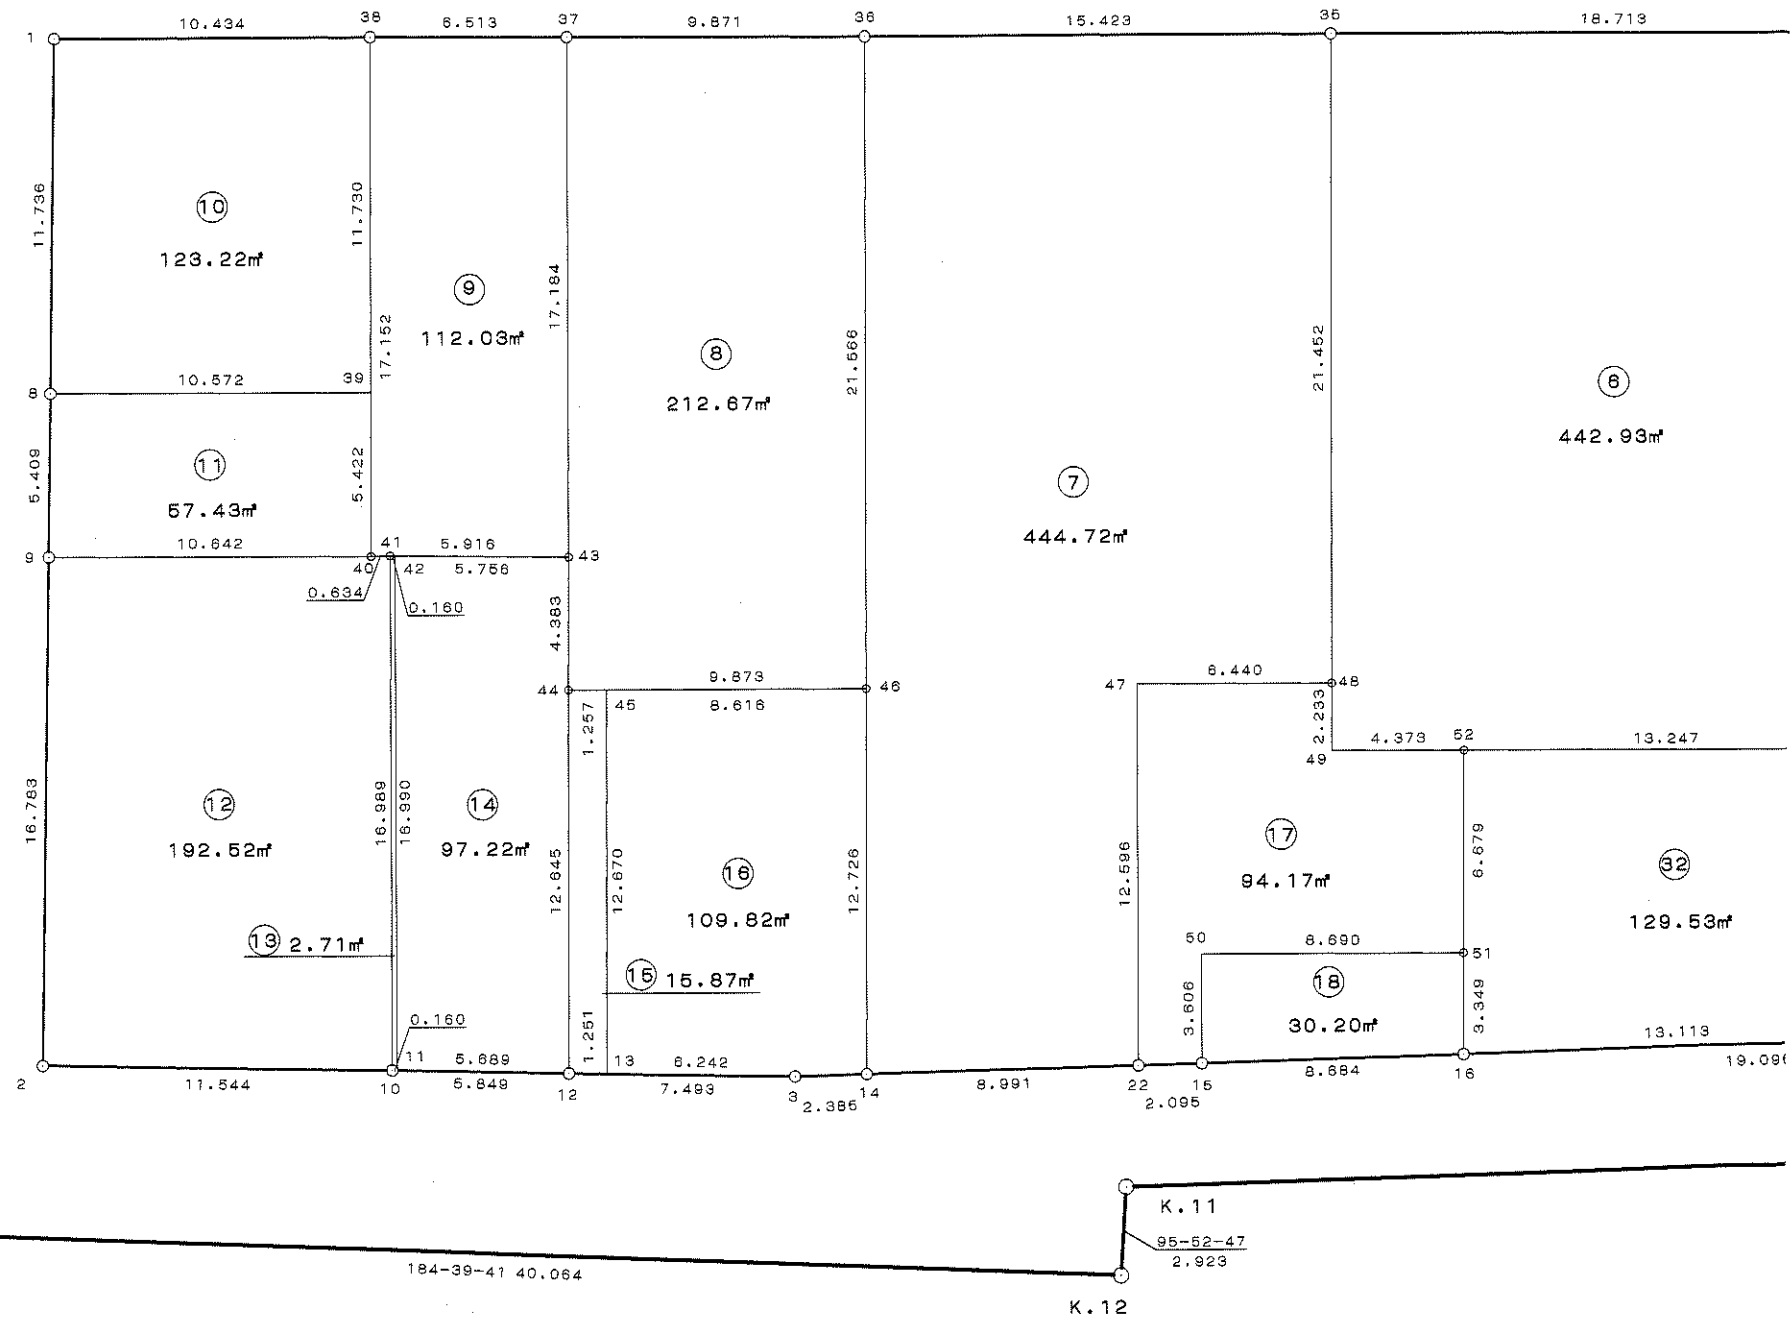


座標データリスト

現場名：佐野駅南地区 出来形


No	点 名	X	Y	No	点 名	X	Y	No	点 名	X	Y
1	20B7	34690.5238010	-22510.4134295	26	20B5	34694.5416290	-22481.6437875	51	20B 40	34605.5435843	-22496.8837548
2	20B31	34681.2891459	-22510.8022153	27	20B27	34694.4560935	-22485.9574646	52	20B 41	34606.1773673	-22496.8793754
3	20B 32	34676.7039628	-22510.9991636	28	20B28	34694.2518127	-22496.1440313	53	20B 39	34605.7798781	-22502.3006505
4	20B33	34667.8043044	-22511.3704299	29	20B 29	34694.2432618	-22496.6478525	54	20B42	34606.3369658	-22496.8707064
5	20B 34	34656.7638920	-22511.8381265	30	20B 30	34694.1565357	-22500.9914093	55	20B11	34605.6391743	-22479.8948043
6	20B 35	34638.0685032	-22512.6412510	31	20B6	34694.0340450	-22506.8162662	56	20B 45	34613.1313746	-22492.1268542
7	20B36	34622.6595161	-22513.3051298	32	20B 66	34680.8787685	-22501.5521734	57	20B 13	34612.5659551	-22479.4696403
8	20B37	34612.7978752	-22513.7276281	33	20B 63	34675.9009683	-22492.3867451	58	20B50	34632.4174080	-22482.4900370
9	20B 38	34606.2910725	-22514.0194810	34	20B64	34678.8386002	-22492.2703249	59	20B51	34641.0987539	-22482.1123750
10	20B1	34595.8668265	-22514.4804466	35	20B65	34680.4687683	-22492.1986996	60	20B57	34655.2766651	-22488.1822293
11	20B8	34595.2184377	-22502.7619443	36	20B68	34680.6712746	-22496.7259533	61	20B 19	34654.0607502	-22478.5957941
12	20B9	34594.9124405	-22497.3618999	37	20B 67	34680.6880928	-22497.2241559	62	20B20	34654.6970180	-22478.5874999
13	20B2	34593.9568179	-22480.6065141	38	20B71	34667.5863552	-22506.0101309	63	20B 58	34660.4136785	-22487.9847709
14	20B 10	34605.4796203	-22479.9045562	39	20B61	34666.9999970	-22492.7798589	64	20B 94	34666.7494686	-22506.0480186
15	20B12	34611.3174184	-22479.5477516	40	20B 62	34668.3186526	-22492.7268901	65	20B 92	34665.5380005	-22478.4417538
16	20B3	34618.7956856	-22479.0798942	41	20B48	34637.1351649	-22491.2100492	66	20B69	34678.5901046	-22486.6304678
17	20B14	34621.1808529	-22479.0450092	42	20B49	34637.0383819	-22488.9786628	67	20B 70	34684.9982882	-22486.3701544
18	20B22	34630.1712781	-22478.9150909	43	20B52	34641.4069911	-22488.7845968	68	20B 95	34678.7911804	-22491.1940849
19	20B15	34632.2656537	-22478.8876570	44	20B56	34654.6416951	-22488.2120051	69	20B 93	34694.3647063	-22490.5145367
20	20B16	34640.9488955	-22478.7667170	45	20B53	34655.7285066	-22488.1610410				
21	20B 21	34660.0431915	-22478.5178085	46	20B59	34656.5002123	-22506.5120256				
22	20B 24	34667.6904590	-22478.4119611	47	20B 46	34621.7395796	-22491.7587326				
23	20B25	34678.2304373	-22478.2651962	48	20B47	34630.7014234	-22491.4996460				
24	20B 26	34684.6156449	-22478.1872992	49	20B43	34612.0842393	-22496.5585275				
25	20B4	34691.0090258	-22478.0981412	50	20B 44	34611.8756073	-22492.1805559				

街区面積 1,572.55 m²

画地面積 1,572.49 m²

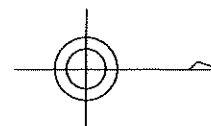

略 ☒ $S = 1 / 250$

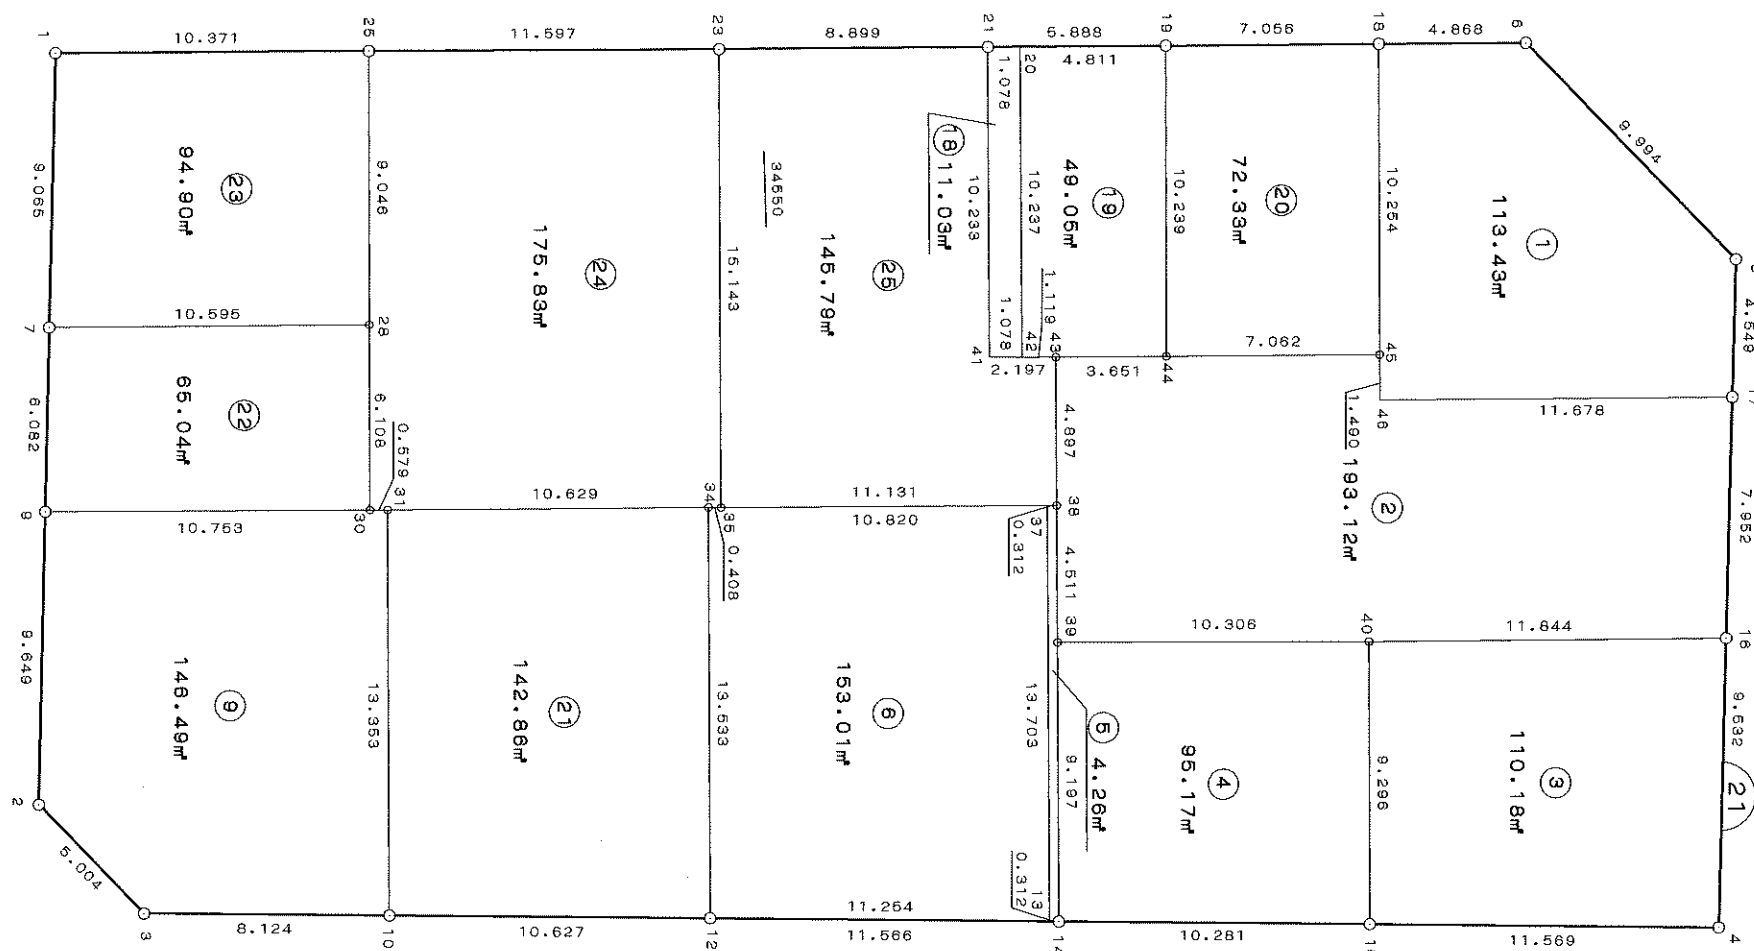


座標データリスト

現場名：佐野駅南地区 出来形


No	点 名	X	Y	No	点 名	X	Y
1	21B6	34578.7281312	-22550.3394994	26	21B 40	34572.9333036	-22530.7766966
2	21B18	34573.8618597	-22550.4744643	27	21B37	34562.4358656	-22535.6329850
3	21B19	34566.8081228	-22550.6583928	28	21B13	34562.0928579	-22521.9342864
4	21B 21	34560.9218365	-22550.8189090	29	21B35	34551.6201121	-22535.9294885
5	21B23	34552.0264115	-22551.0670368	30	21B 34	34551.2125179	-22535.9519350
6	21B25	34540.4341527	-22551.3929275	31	21B31	34540.5868389	-22536.2256423
7	21B1	34530.0664355	-22551.6724112	32	21B30	34540.0084094	-22536.2452433
8	21B7	34529.5812069	-22542.6206675	33	21B20	34561.9990981	-22550.7895326
9	21B9	34529.2594438	-22536.5467626	34	21B 41	34560.6739151	-22540.5889669
10	21B2	34528.7469209	-22526.9117297	35	21B42	34561.7510677	-22540.5550951
11	21B3	34532.1144428	-22523.2103708	36	21B28	34540.1725958	-22542.3511307
12	21B10	34540.2315836	-22522.8772175				
13	21B 12	34550.8491924	-22522.4233839				
14	21B14	34562.4042901	-22521.9207392				
15	21B 15	34572.6755290	-22521.4841566				
16	21B4	34584.2330210	-22520.9711038				
17	21B 16	34584.7734332	-22530.4873797				
18	21B17	34585.2214425	-22538.4267621				
19	21B5	34585.4772599	-22542.9689787				
20	21B45	34573.5795354	-22540.2243516				
21	21B46	34573.5473484	-22538.7345705				
22	21B44	34566.5198601	-22540.4234514				
23	21B43	34562.8700029	-22540.5199095				
24	21B38	34562.7474232	-22535.6244439				
25	21B 39	34562.6328118	-22531.1148997				

街区面積 1,842.72 m²

画地面積 1,842.65 m²

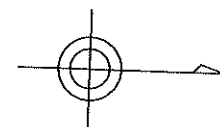

略 ☒ S = 1 / 250

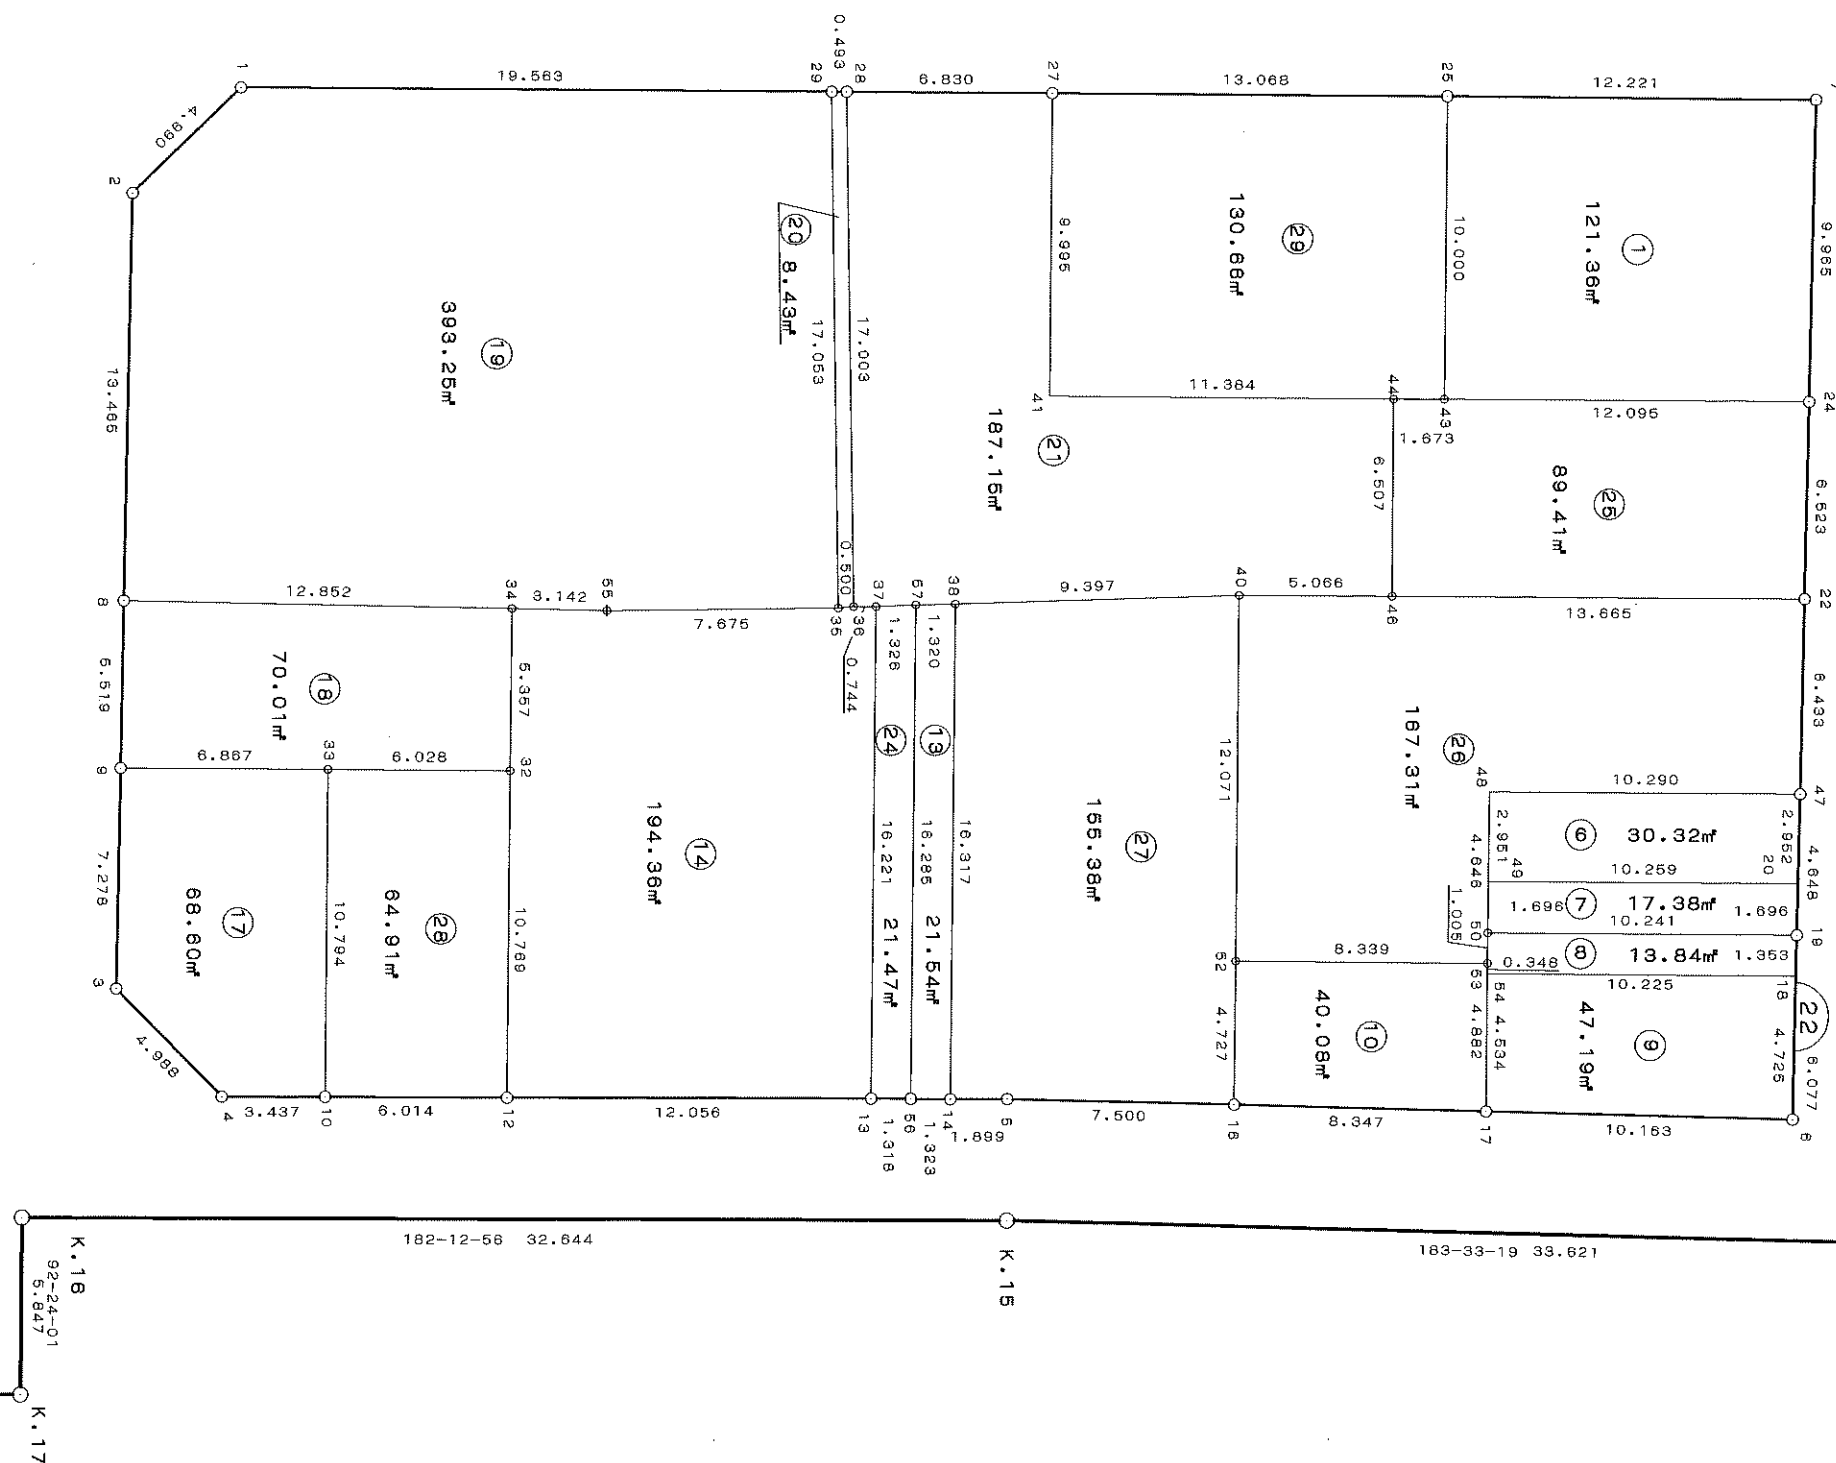

座標データリスト


現場名：佐野駅南地区 出来形

No	点 名	X	Y	No	点 名	X	Y
1	22B1	34531.7577764	-22517.2591452	26	22B33	34533.9005138	-22494.6510712
2	22B2	34528.0622266	-22513.9057801	27	22B34	34540.1585229	-22499.7450165
3	22B3	34526.6493132	-22487.6819584	28	22B 35	34550.9674486	-22499.3738957
4	22B4	34530.0148467	-22484.0010798	29	22B 36	34551.4663298	-22499.4013167
5	22B5	34556.0422400	-22482.9883571	30	22B 37	34552.2093224	-22499.3727087
6	22B6	34582.0016291	-22481.3725102	31	22B 38	34554.8550367	-22499.3596307
7	22B7	34583.8815248	-22514.9656638	32	22B40	34564.2516901	-22499.3148062
8	22B8	34527.3267901	-22500.4607374	33	22B41	34558.2019943	-22506.1077852
9	22B9	34527.0400220	-22494.9492153	34	22B 43	34571.2469332	-22505.5360697
10	22B10	34533.4489222	-22483.8665221	35	22B44	34569.5747473	-22505.5990496
11	22B12	34539.4587656	-22483.6338239	36	22B46	34569.3130015	-22499.0968917
12	22B 13	34551.5052994	-22483.1670752	37	22B 47	34582.6088962	-22492.0802349
13	22B 14	34554.1442573	-22483.0583044	38	22B 48	34572.3288114	-22492.5311042
14	22B16	34563.5280799	-22482.5328396	39	22B49	34572.1904352	-22489.5838174
15	22B17	34571.8581804	-22482.0084211	40	22B50	34572.1109095	-22487.8899938
16	22B18	34582.2660485	-22486.0896201	41	22B 52	34563.7345364	-22487.2553228
17	22B19	34582.3417552	-22487.4401898	42	22B 53	34572.0655298	-22486.8862849
18	22B20	34582.4392282	-22489.1332244	43	22B54	34572.0507563	-22486.5387402
19	22B22	34582.9650887	-22498.5029722	44	22B55	34543.2946034	-22499.5564925
20	22B24	34583.3303873	-22505.0157916	45	22B56	34552.8224085	-22483.1138231
21	22B 25	34571.6733065	-22515.5273668	46	22B57	34553.5349171	-22499.3828713
22	22B27	34558.6180919	-22516.0946048				
23	22B 28	34551.7951990	-22516.4014689				
24	22B 29	34551.3026477	-22516.4232232				
25	22B32	34539.9231056	-22494.3931217				

略 $\square$ $S = 1 / 250$

街区面積 1,128.42 m²

画地面積 1,128.41 m²

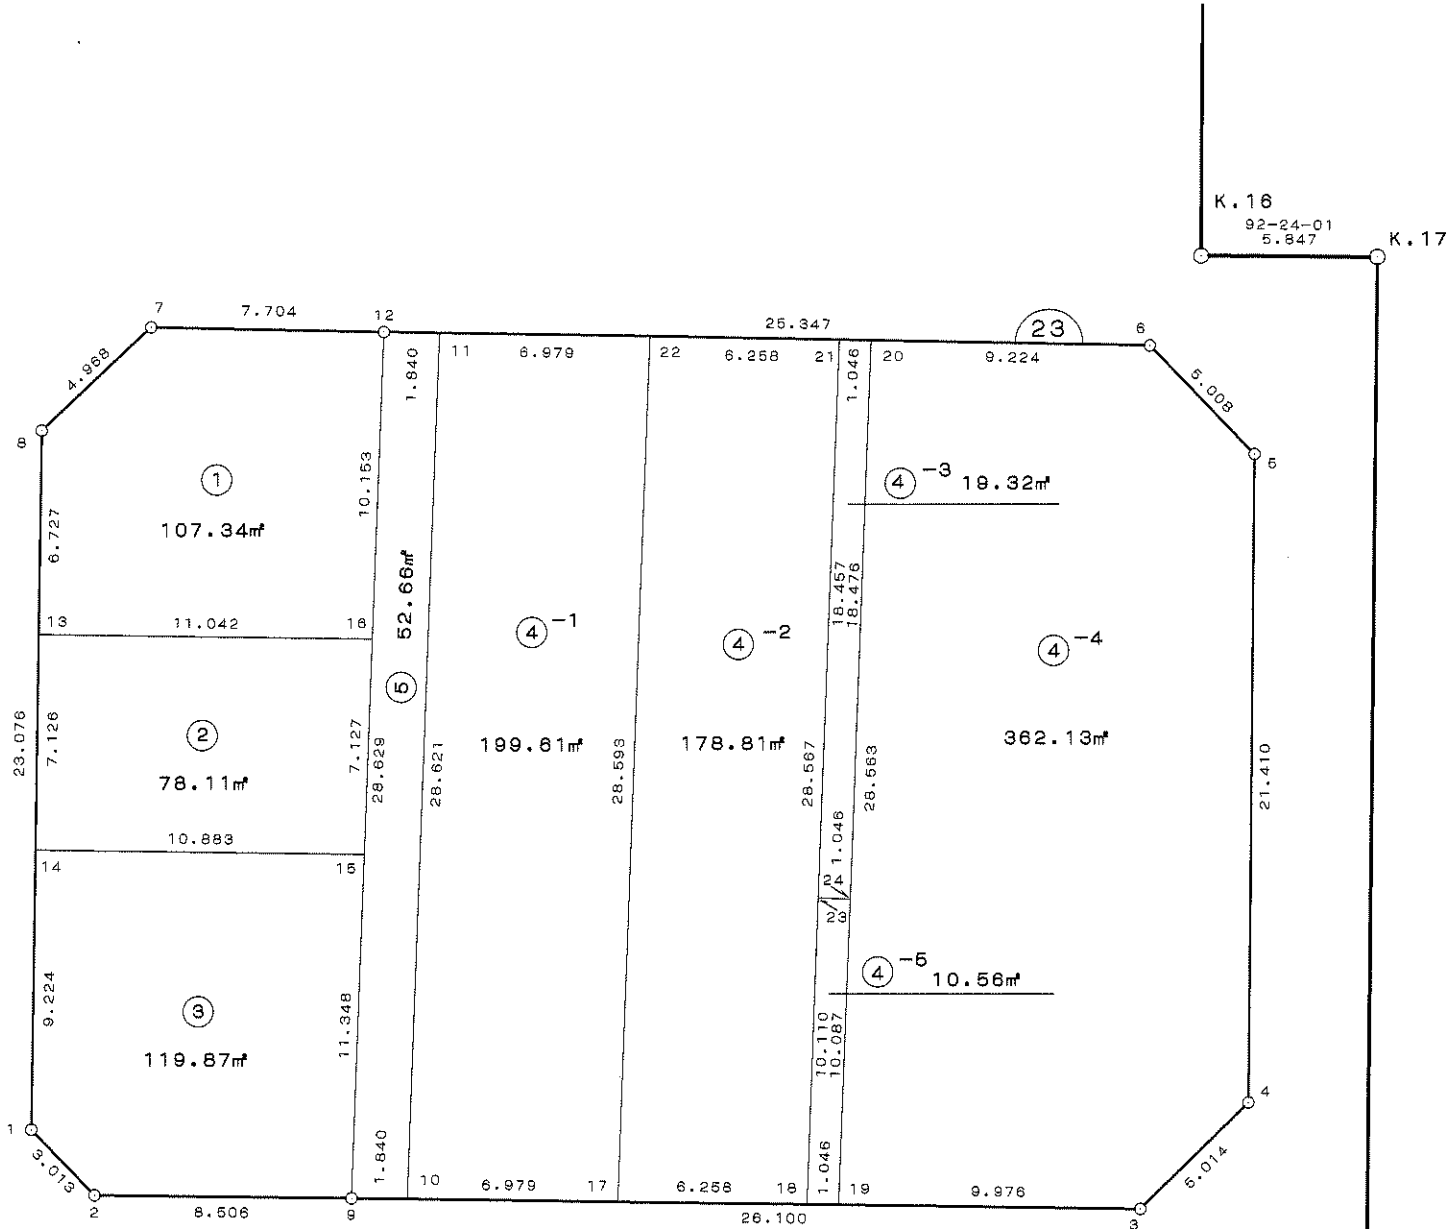

座標データリスト

現場名：佐野駅南地区 出来形



No	点 名	X	Y
1	23B1	34495.7754010	-22519.8929059
2	23B2	34493.5387070	-22517.8737779
3	23B3	34491.8746558	-22483.3082082
4	23B4	34495.2542503	-22479.6042860
5	23B5	34516.6442934	-22478.6900349
6	23B6	34520.3649184	-22482.0420309
7	23B7	34522.1097997	-22515.0472428
8	23B8	34518.8246233	-22518.7741974
9	23B 9	34493.1412837	-22509.3771341
10	23B10	34493.0519821	-22507.5391866
11	23B11	34521.6014887	-22505.5165044
12	23B 12	34521.6982788	-22507.3539214
13	23B13	34512.1059147	-22519.1002941
14	23B14	34504.9886832	-22519.4457334
15	23B15	34504.4610725	-22508.5751471
16	23B16	34511.5706227	-22508.0714480
17	23B 17	34492.7132679	-22500.5679864
18	23B 18	34492.4095620	-22494.3173069
19	23B 19	34492.3587761	-22493.2720630
20	23B 20	34520.8501530	-22491.2534992
21	23B 21	34520.9051977	-22492.2984415
22	23B 22	34521.2343712	-22498.5473166
23	23B 23	34502.4942408	-22493.6028253
24	23B 24	34502.4203033	-22492.5592215

街区番号 24 B ①


街区面積 3,548.85 m²

画地面積 3,548.73 m²

略 ☒ S = 1 / 250

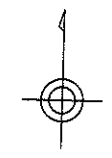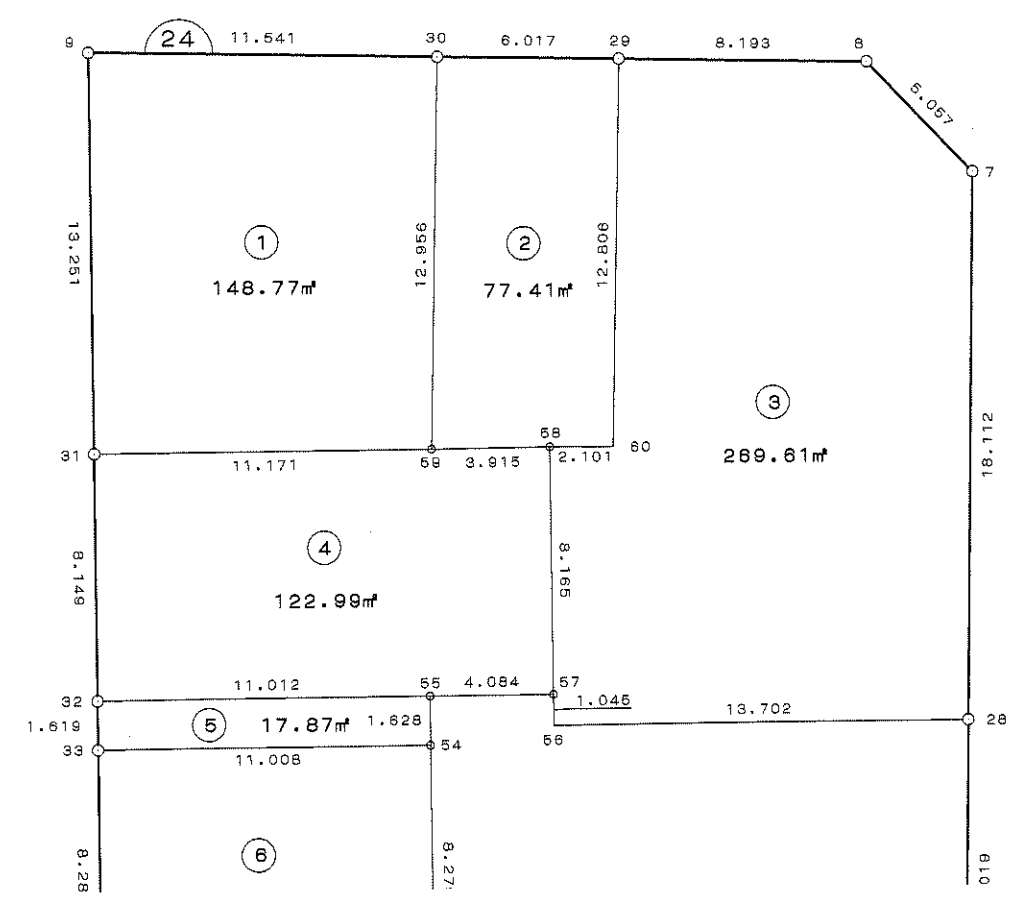

K.17

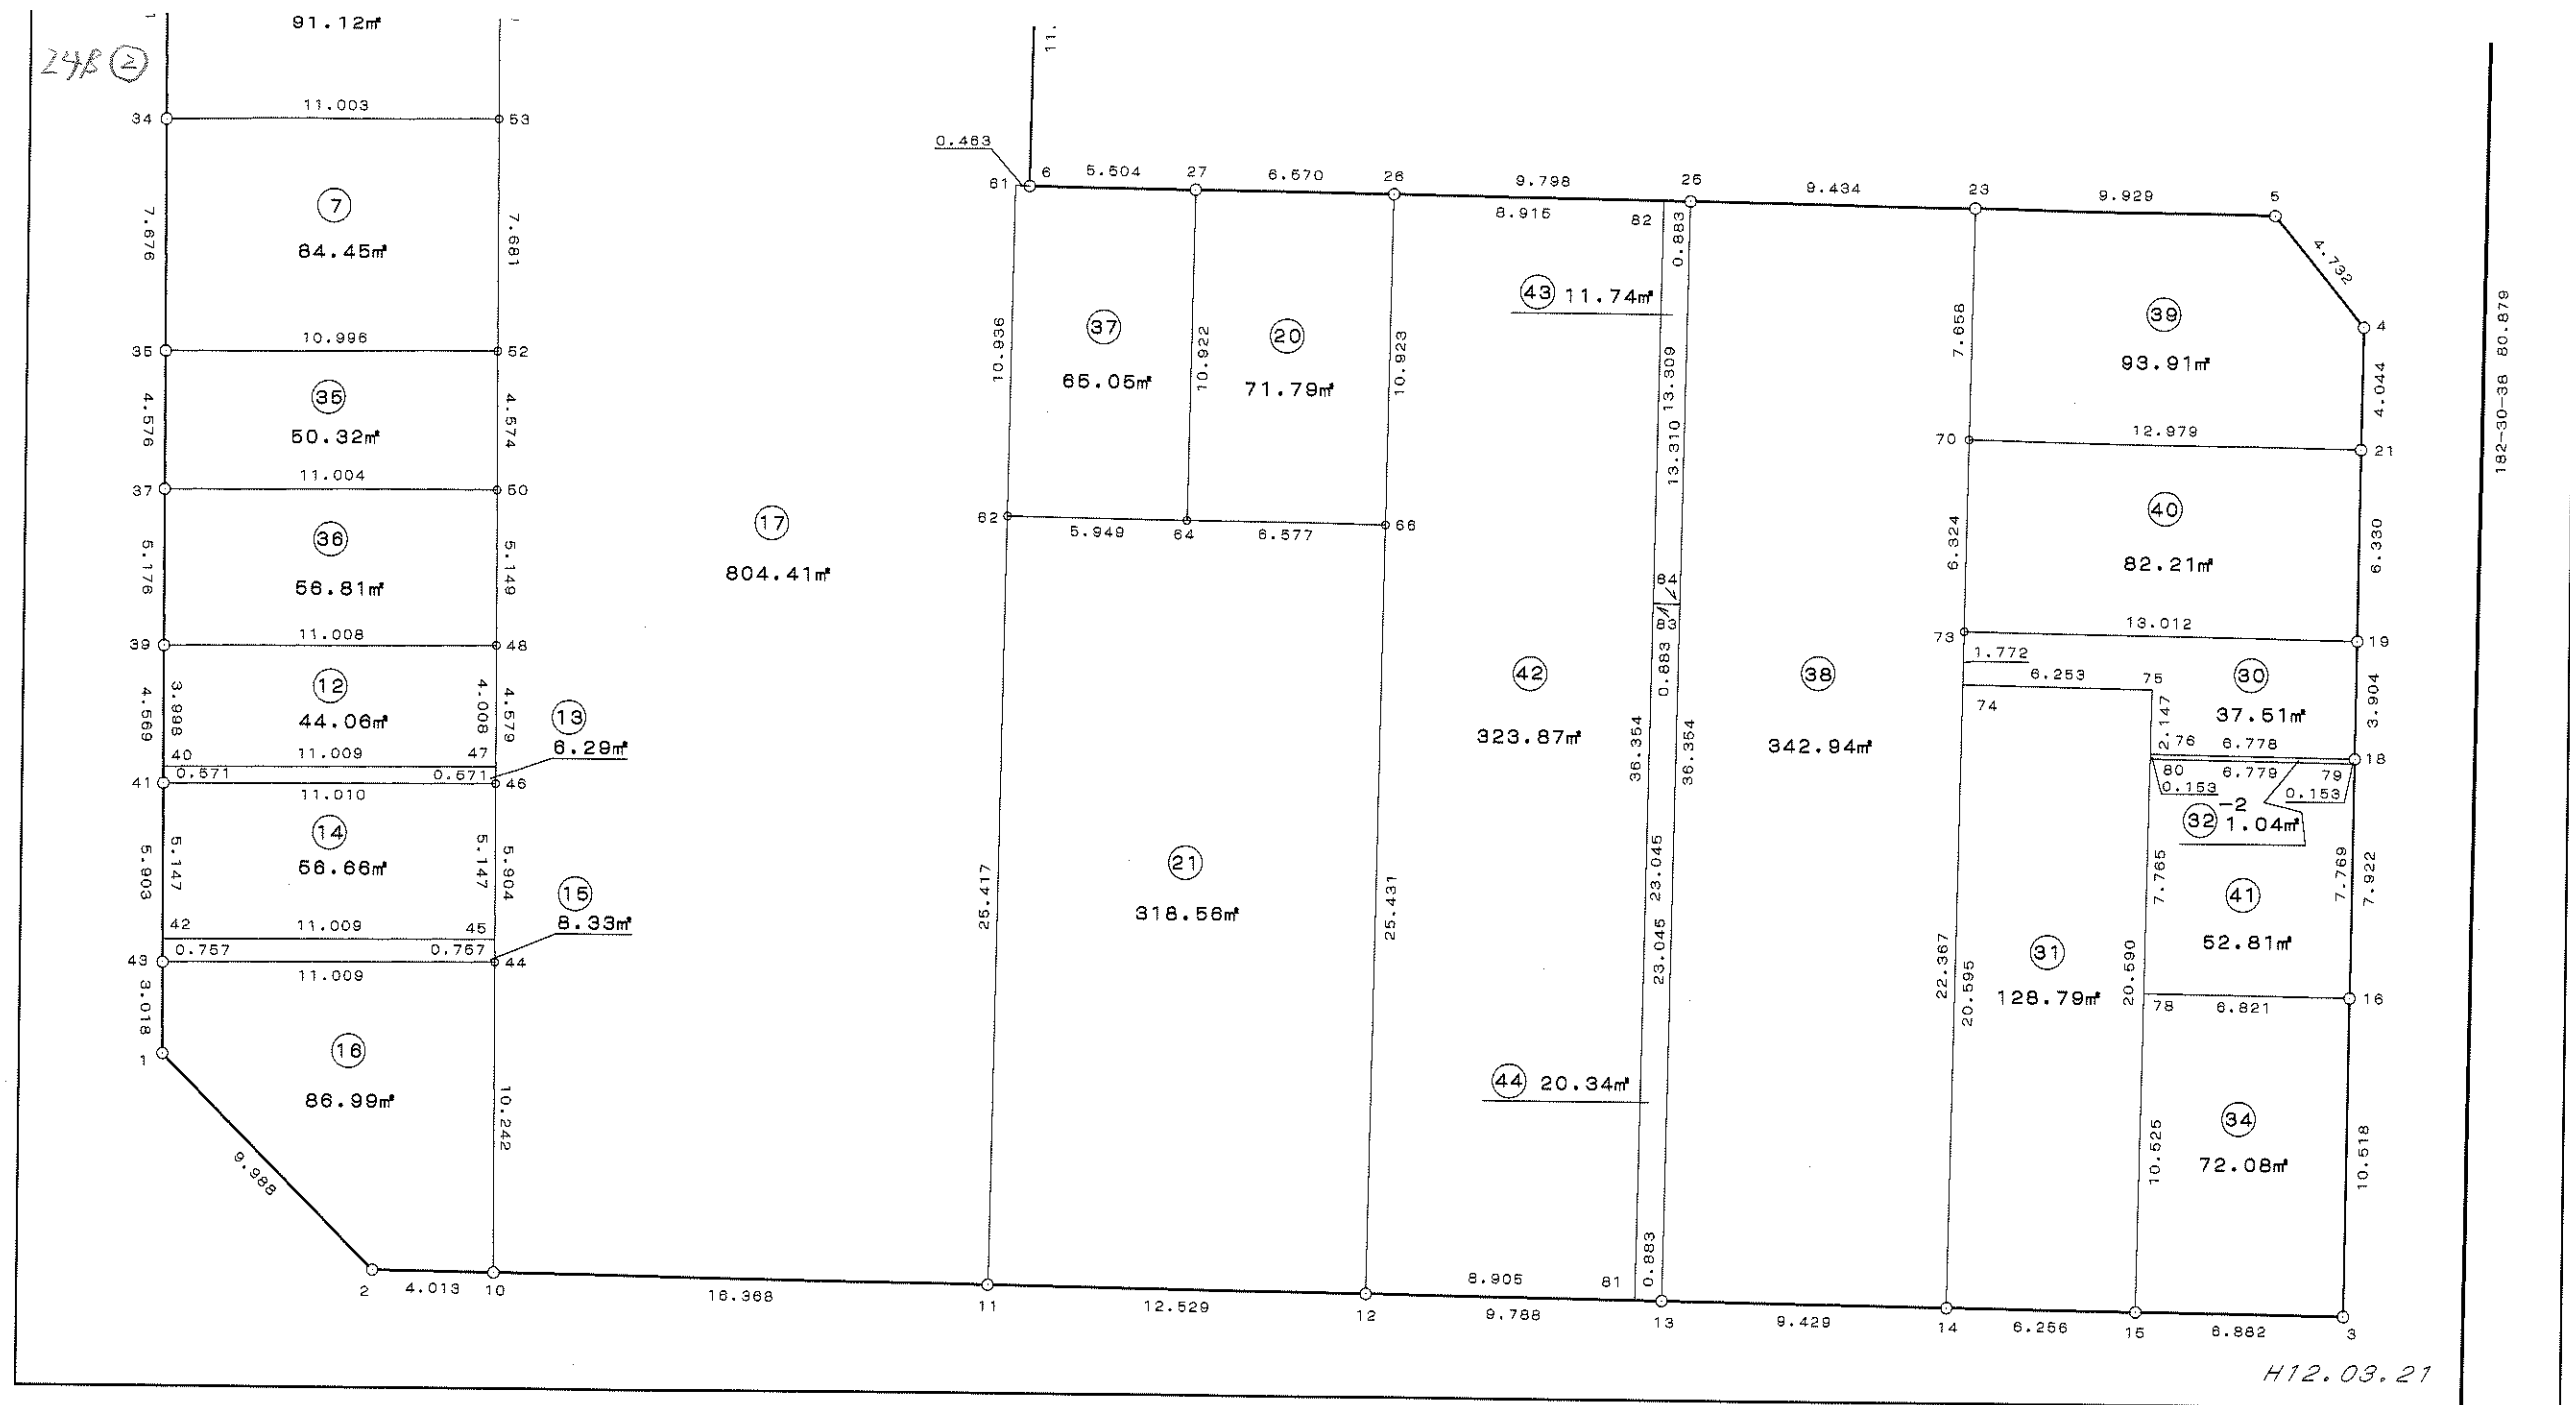

座標データリスト

現場名：佐野駅南地区 出来形

No	点 名	X	Y	No	点 名	X	Y	No	点 名	X	Y
1	24B1	34461.8898025	-22553.5207377	26	24B30	34523.4678960	-22540.3002568	51	24B59	34510.5311730	-22541.0120069
2	24B2	34454.5668835	-22546.7284461	27	24B31	34510.8387546	-22552.1787717	52	24B60	34510.3588654	-22534.9984726
3	24B3	34451.3967140	-22481.5428009	28	24B32	34502.6929478	-22552.4024453	53	24B61	34489.8712861	-22524.6263316
4	24B4	34484.0840621	-22480.1240022	29	24B33	34501.0745811	-22552.4484329	54	24B62	34478.9473481	-22525.1400161
5	24B5	34487.8580717	-22482.9778230	30	24B34	34492.7967932	-22552.6746183	55	24B64	34478.6783621	-22519.1974099
6	24B6	34489.8288699	-22524.1651686	31	24B35	34485.1239043	-22552.8768700	56	24B66	34478.3564700	-22512.6285266
7	24B7	34518.9257505	-22522.7603110	32	24B37	34480.5494631	-22553.0079644	57	24B70	34480.6855626	-22493.2686411
8	24B8	34522.7133056	-22526.1110907	33	24B39	34475.3755274	-22553.1519093	58	24B73	34474.3686540	-22493.5681204
9	24B9	34524.0850853	-22551.8250615	34	24B 40	34471.3789509	-22553.2621313	59	24B 74	34472.5990784	-22493.6549883
10	24B10	34454.3732067	-22542.7203428	35	24B41	34470.8078177	-22553.2778826	60	24B 75	34472.2925067	-22487.4098531
11	24B11	34453.5602607	-22526.3727690	36	24B 42	34465.6630937	-22553.4197052	61	24B76	34470.1478064	-22487.5148194
12	24B12	34452.9552952	-22513.8585411	37	24B43	34464.9067453	-22553.4405552	62	24B78	34462.2392725	-22487.9018803
13	24B13	34452.4850647	-22504.0822869	38	24B44	34464.6112343	-22542.4351139	63	24B 79	34469.6660503	-22480.7517242
14	24B14	34452.0287594	-22494.6647789	39	24B 45	34465.3675822	-22542.4142430	64	24B 80	34469.9945383	-22487.5223207
15	24B15	34451.7268554	-22488.4163809	40	24B46	34470.5129879	-22542.2722587	65	24B 81	34452.5274696	-22504.9638984
16	24B16	34461.9048027	-22481.0891373	41	24B 47	34471.0841251	-22542.2566532	66	24B 82	34488.8388926	-22503.1989725
17	24B18	34469.8193589	-22480.7450593	42	24B48	34475.0902799	-22542.1471910	67	24B 83	34475.5455073	-22503.8451009
18	24B19	34473.7198090	-22480.5726600	43	24B50	34480.2374144	-22542.0085567	68	24B 84	34475.5026574	-22502.9635110
19	24B21	34480.0440974	-22480.3058601	44	24B52	34484.8097441	-22541.8849407				
20	24B23	34488.3344381	-22492.8949204	45	24B53	34492.4879032	-22541.6760449				
21	24B25	34488.7965222	-22502.3173594	46	24B54	34500.7636863	-22541.4452467				
22	24B26	34489.2668604	-22512.1038268	47	24B55	34502.3912184	-22541.3941265				
23	24B27	34489.5874338	-22518.6661469	48	24B56	34501.2345191	-22537.3291824				
24	24B28	34500.8345234	-22523.6326244	49	24B57	34502.2791245	-22537.3121184				
25	24B29	34523.1450841	-22534.2922873	50	24B58	34510.4409246	-22537.0980181				